47.33

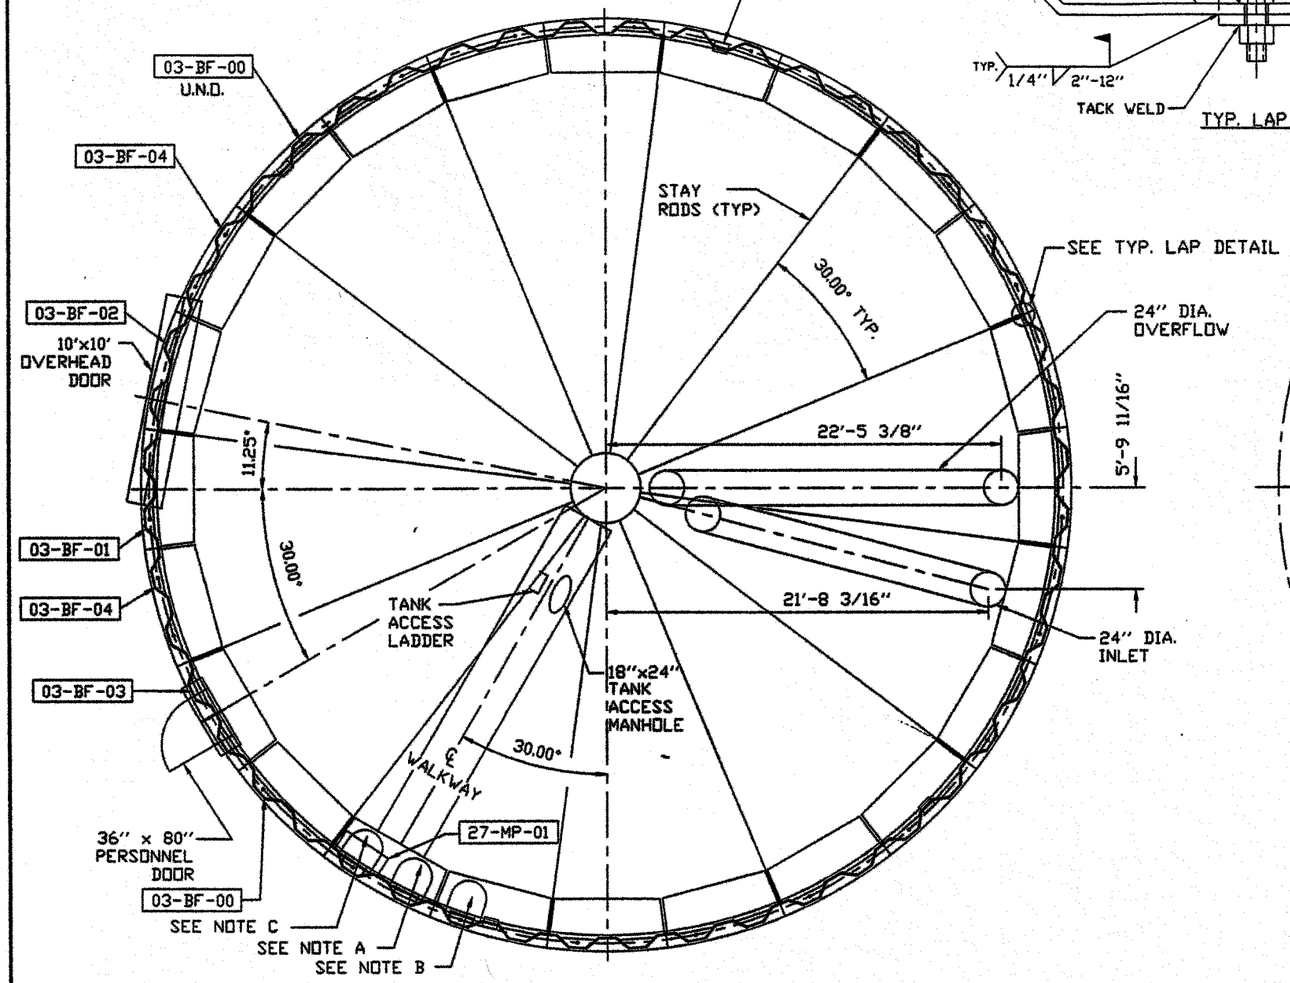

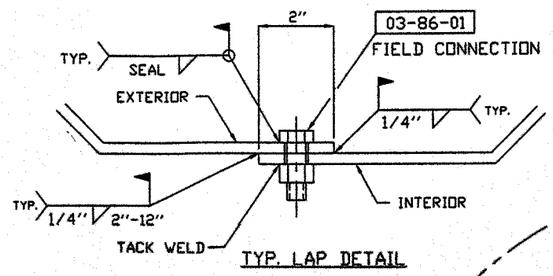

TYP. LAP DETAIL

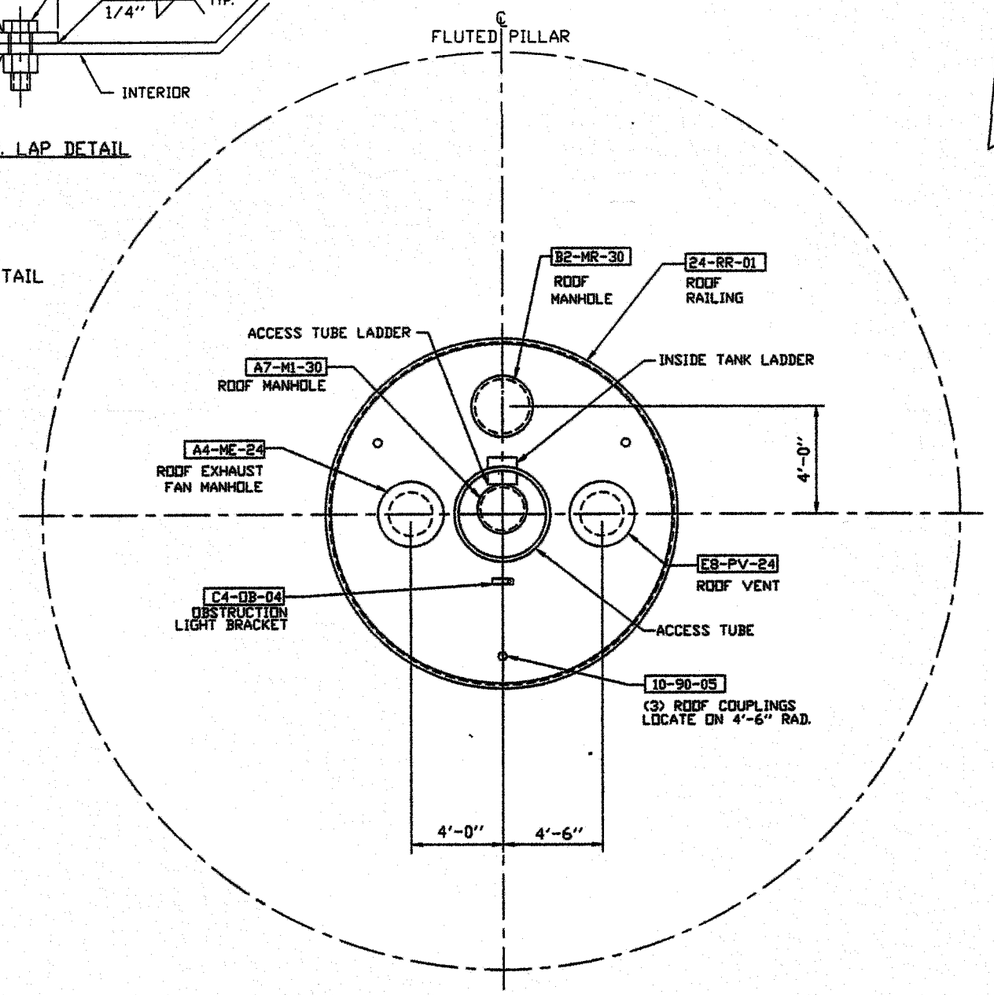

ROOF ORIENTATION

NOTE

A. FLUTE LADDER & OPENING FOR GIRDER LEVEL 1

B. FLUTE LADDER & OPENING FOR GIRDER LEVEL 2

C. FLUTE LADDER & OPENING FOR GIRDER LEVEL 3

FLUTED PEDESTAL ORIENTATION

REFERENCE DRAWINGS:

DWG. #10 ACCESS TUBE
DWG. #15 LADDER ELEVATION

COMMONWEALTH OF VIRGINIA
CHARLES W. BEELER
No. 15585
JUNE 4, 1998
PROFESSIONAL ENGINEER

REV.	BY:	DATE	REMARKS

CALDWELL TANKS, INC.
LOUISVILLE, KY.

BOTETOURT COUNTY, VA

BY: BAW TB
TITLE: ROOF & PEDESTAL ORIENTATION
DATE: 4-98
DRAWING NO: E-4291 02