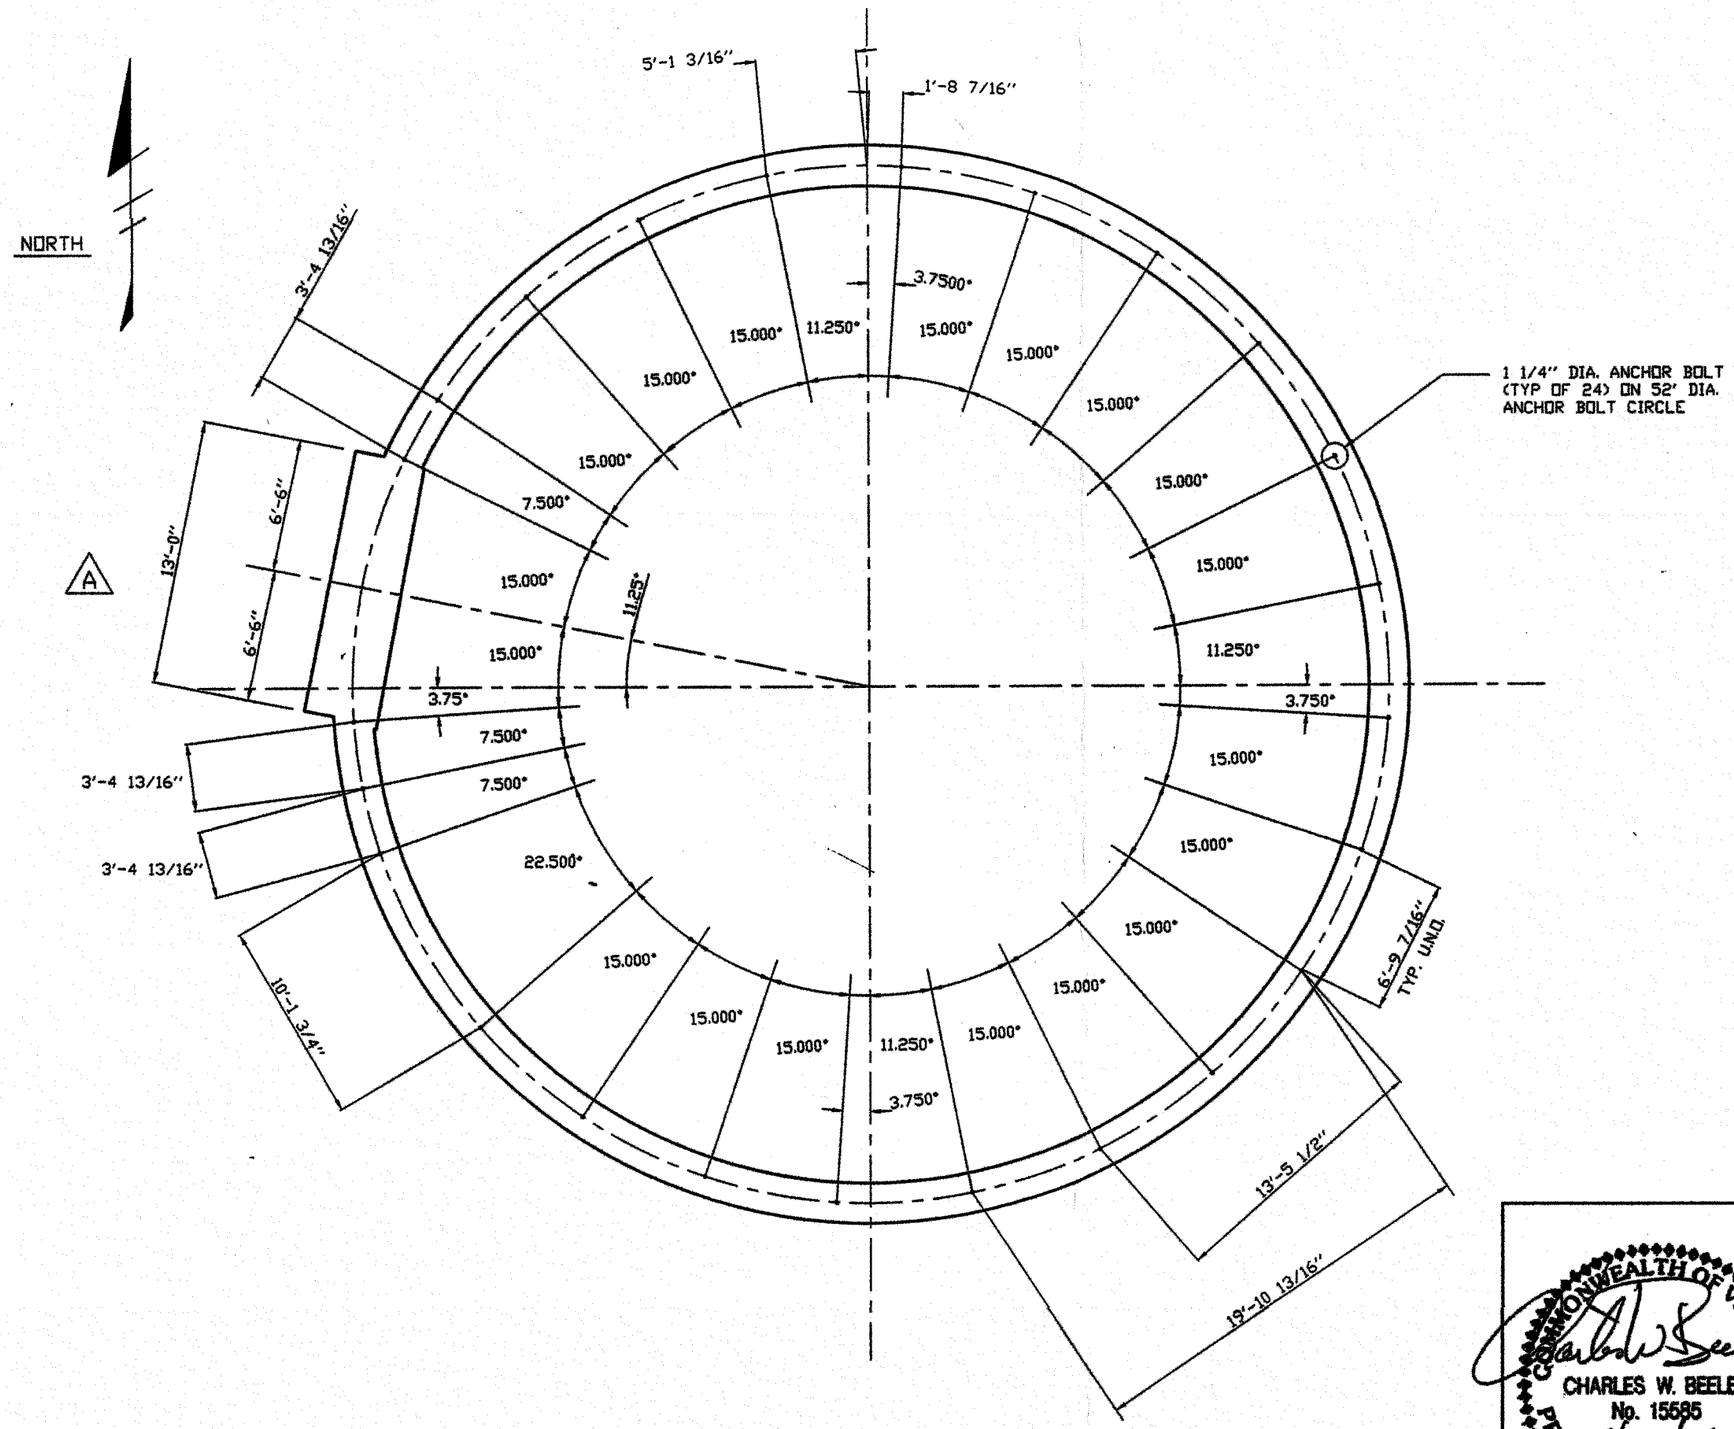

COMMONWEALTH OF VIRGINIA
CHARLES W. BEELER
No. 15585
5/27/98
PROFESSIONAL ENGINEER

REV.	BY:	DATE	REMARKS
A	GAB	5-27	OVERHEAD DOOR ORIENTATION

CALDWELL TANKS, INC.
LOUISVILLE, KY.

1,000,000 GALLON FLUTED COLUMN
BOTETOURT COUNTY, VIRGINIA

BY: BAW
TITLE: ANCHOR BOLT LAYOUT
DATE: 4-98
DRAWING NO.: E-4291 F3 OF 4