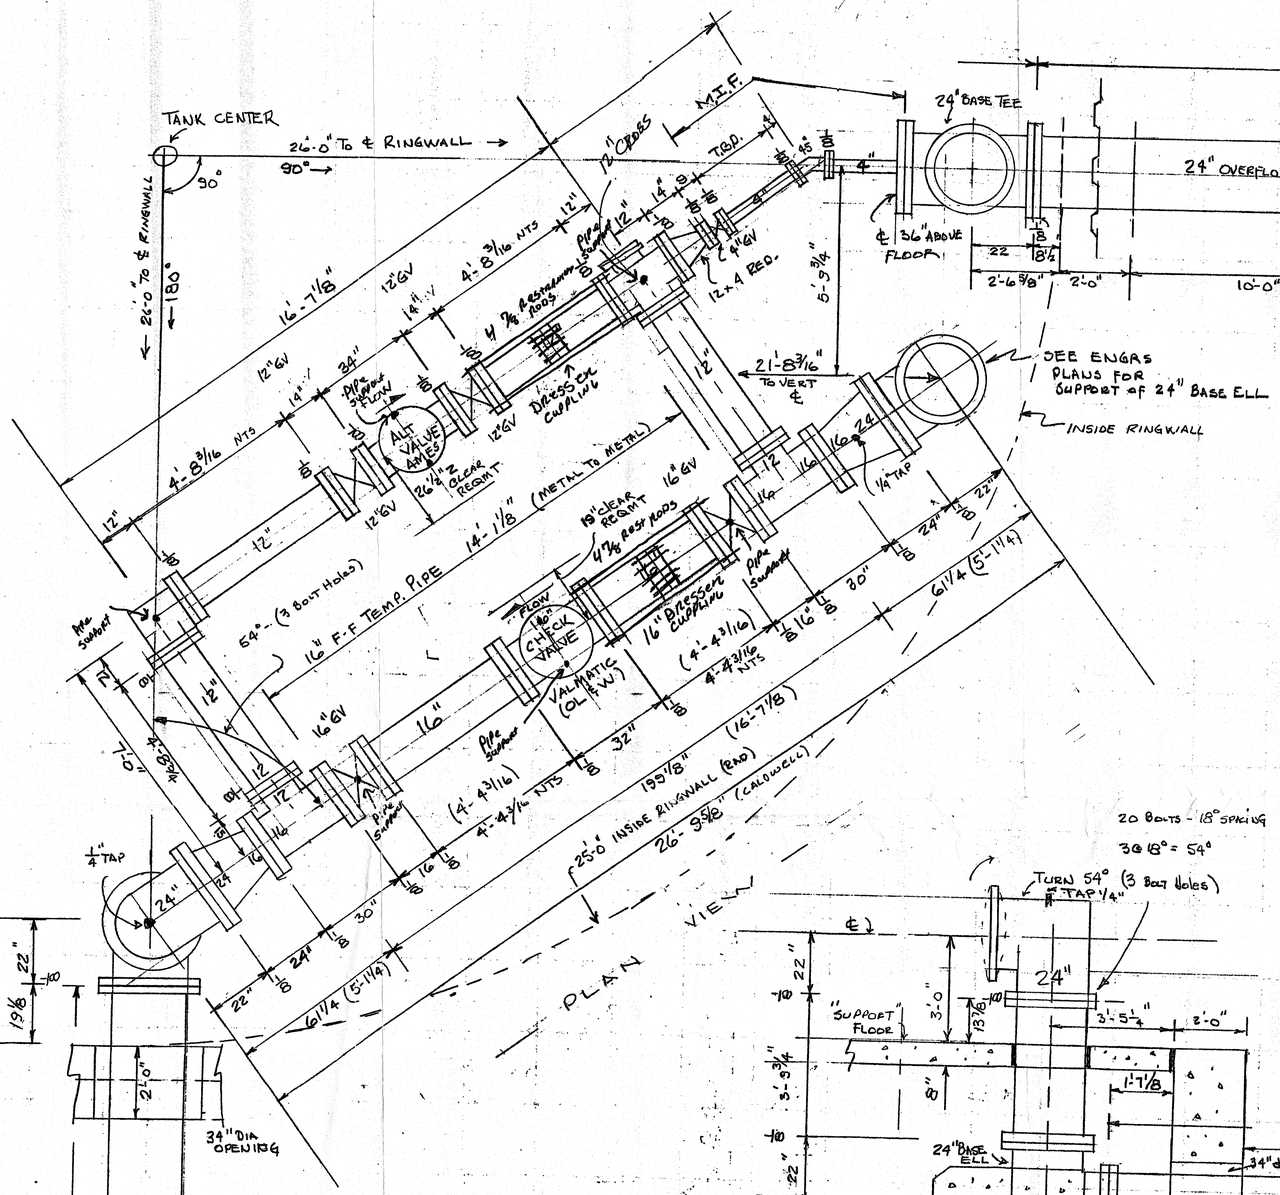

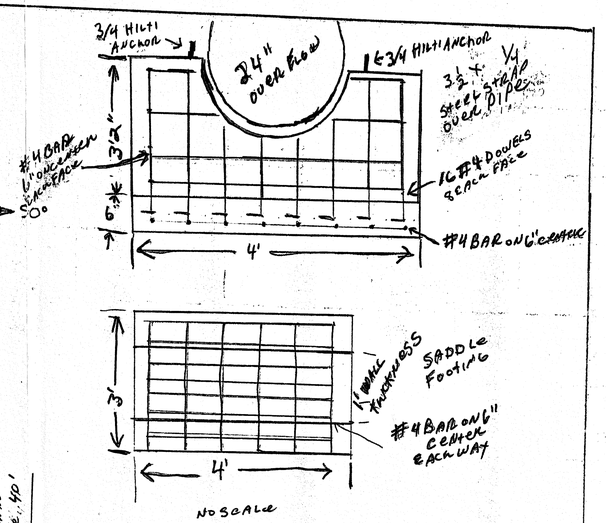

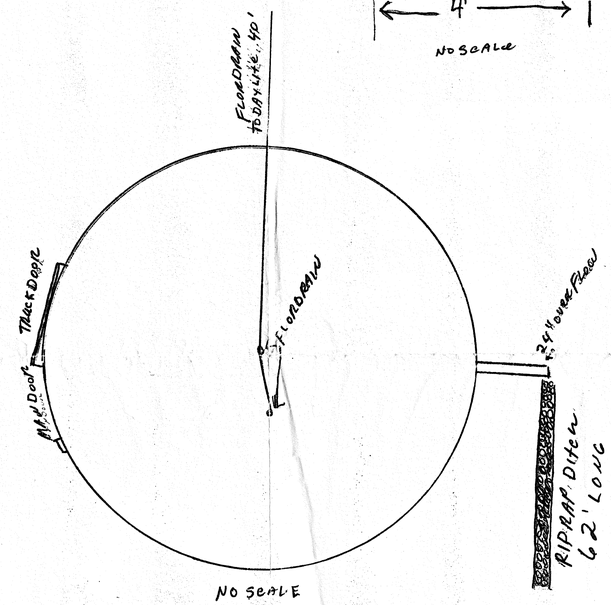

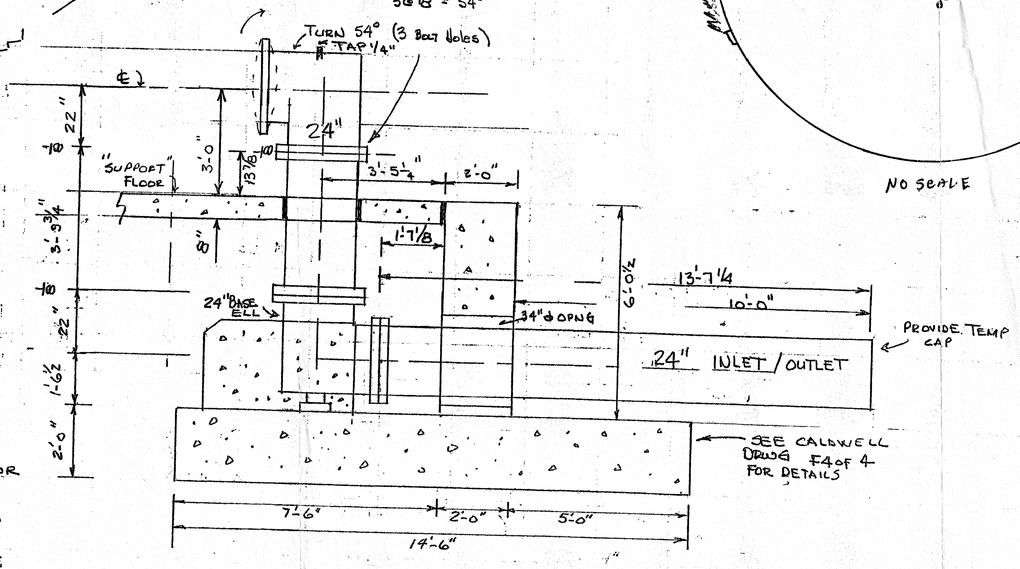

SEC A-A
(ELEVATION)

NOTES

1. SEE CONS. ENGR DRWGS FOR PIPE SUPPORT DETAILS.
2. 16" & 12" FLG. GATE VALVES TO BE INSTALLED "HORIZONTAL".
3. ℄ OF PIPING IS 3'-0" ABOVE RINGWALL & FLOOR.
4. "LAYOUT" OF PAD / FLOOR TO BE DETERMINED IN FIELD.
5. ALL FLANGED REDUCERS SHOWN ON ENGRS PLANS TO BE CONCENTRIC.

AS BUILT DRAWING

AS BUILT
BOTETOURT CO. VA IMMERWT
INTERIOR PIPING DETAILS
DRAWN BY PJB | MAY-1-99
CONTRACTOR - CALDWELL TANKS INC
SCALE 1/2" = 1'-0" OR AS NOTED