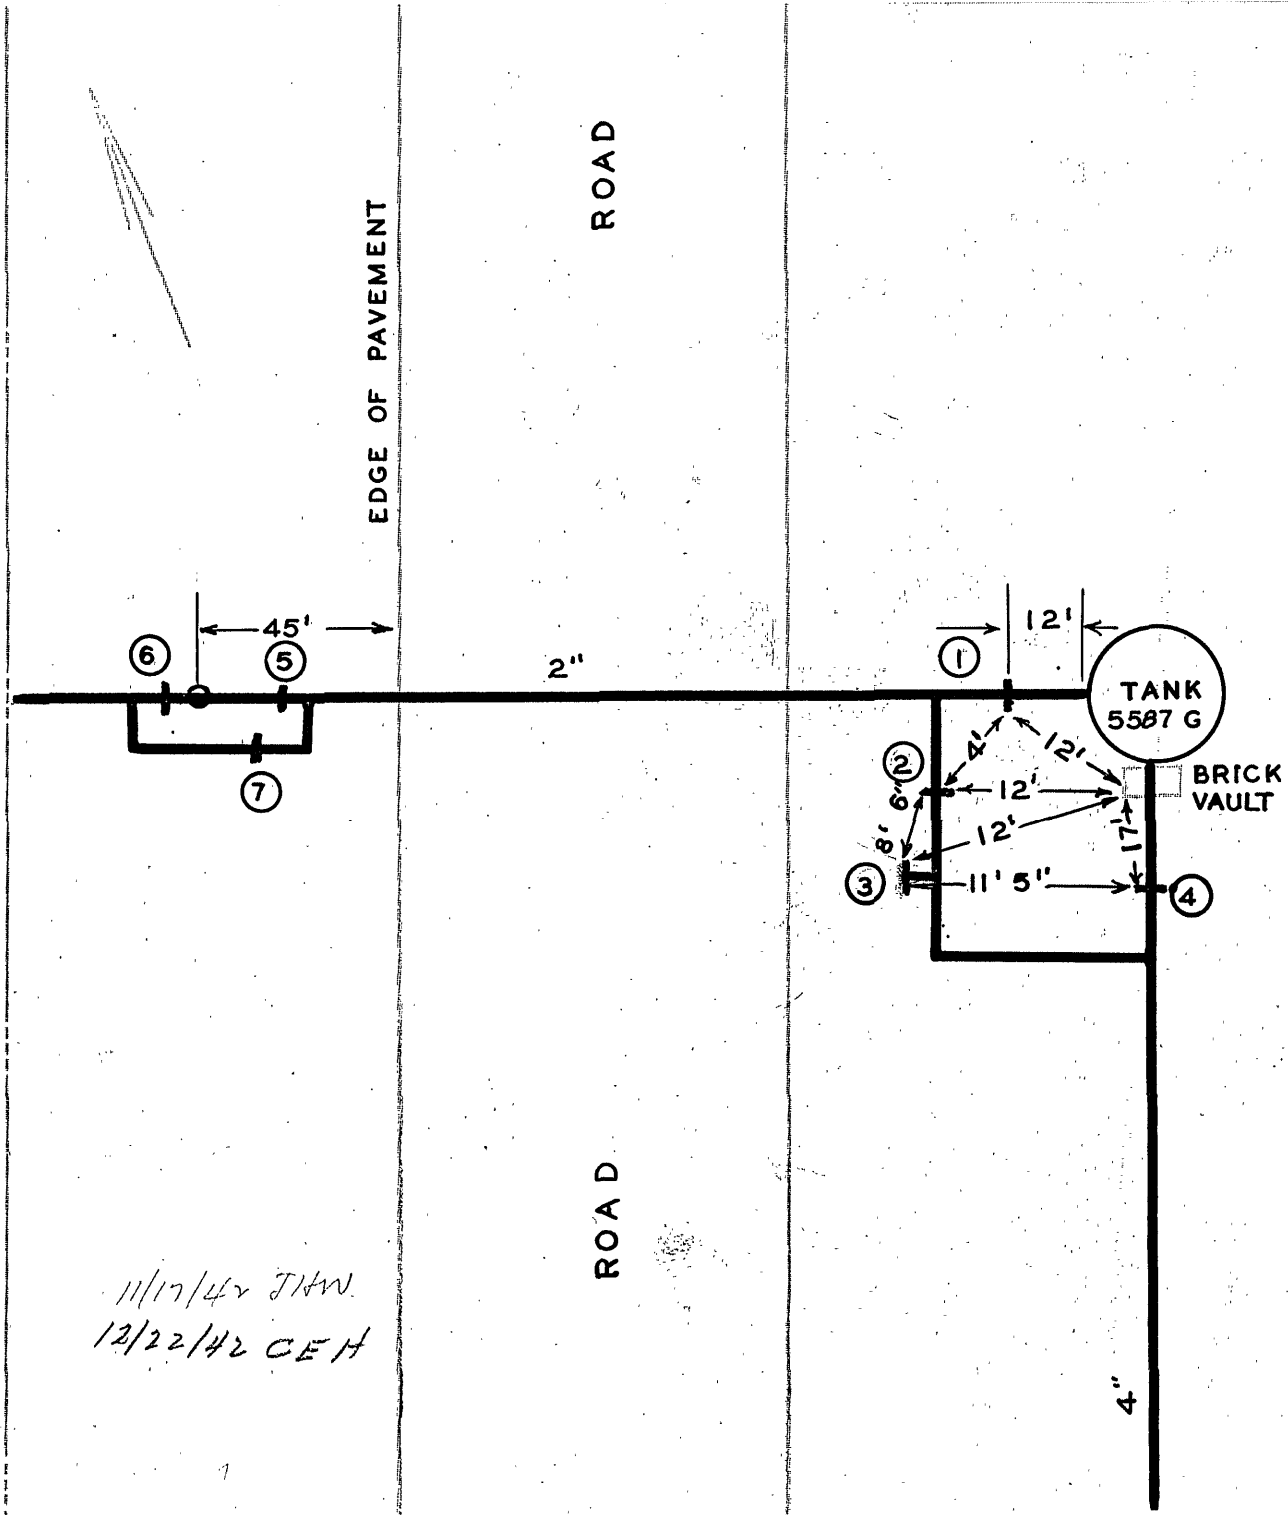

DATE	NO.	SIZE	MAKE	OPEN	TURNS
1934	1	2"		R	7 1/2
1934	2	2"		R	9
1934	3	2"		R	9 1/2
1934	4	4"		R	8
1934	5	2"		R	6
1934	6	2"		R	7
1934	7	2"		L	9

11/17/42 JHW
12/22/42 CEH

CITY OF ROANOKE—WATER DEPT
VALVE DIAGRAM
MILL MOUNTAIN TANK

SEC. MAP 405
DATE
PAGE NO. S.E. 86