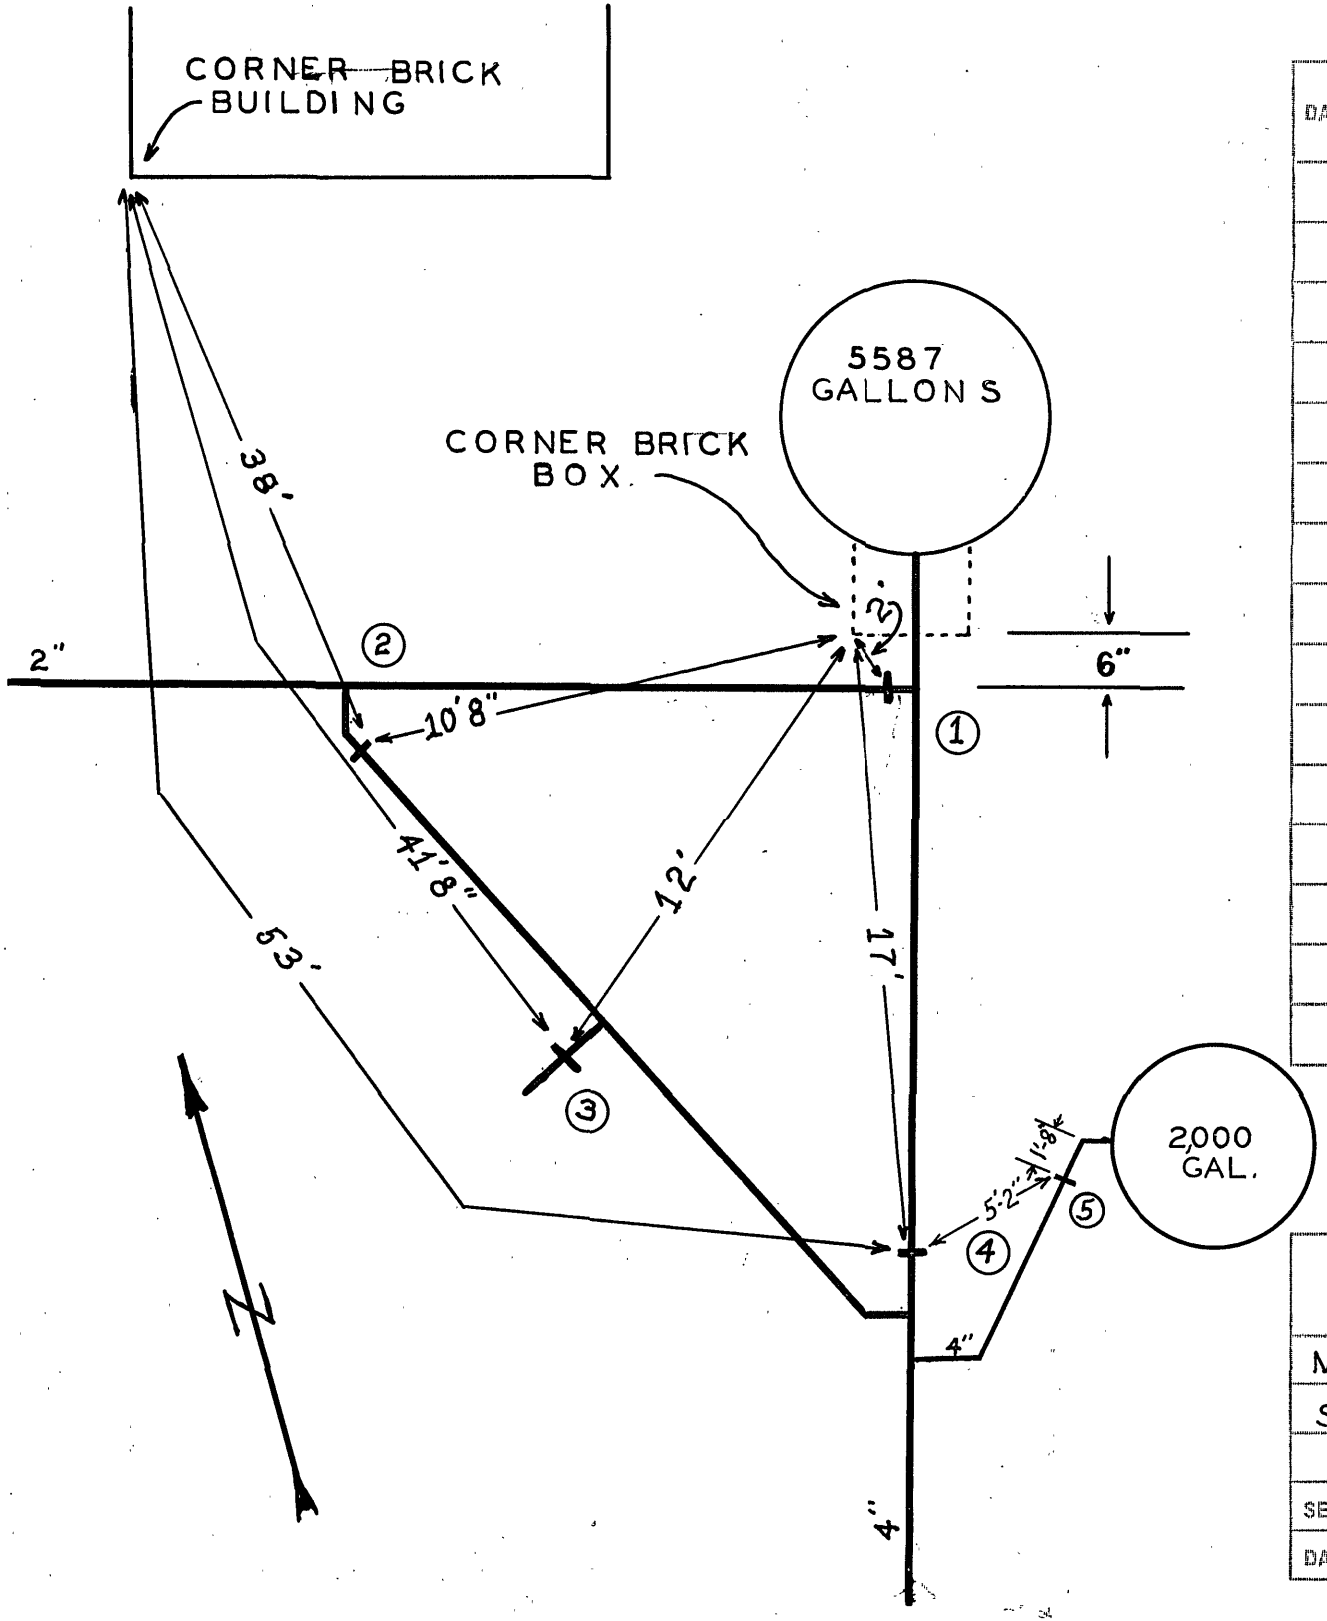

DATE	NO.	SIZE	MAKE	OPEN	TURNS
	1	2"		R	
	2	2"		R	
	3	2"		L	
	4	4"		R	
	5	4"		R	

CITY OF ROANOKE—WATER DEPT.

VALVE DIAGRAM

MILL MOUNTAIN TANK

S.E.

SEC. MAP 405

DATE PAGE NO.

"IMPERIAL" TRACING CLOTH
K & E CO., N. Y.