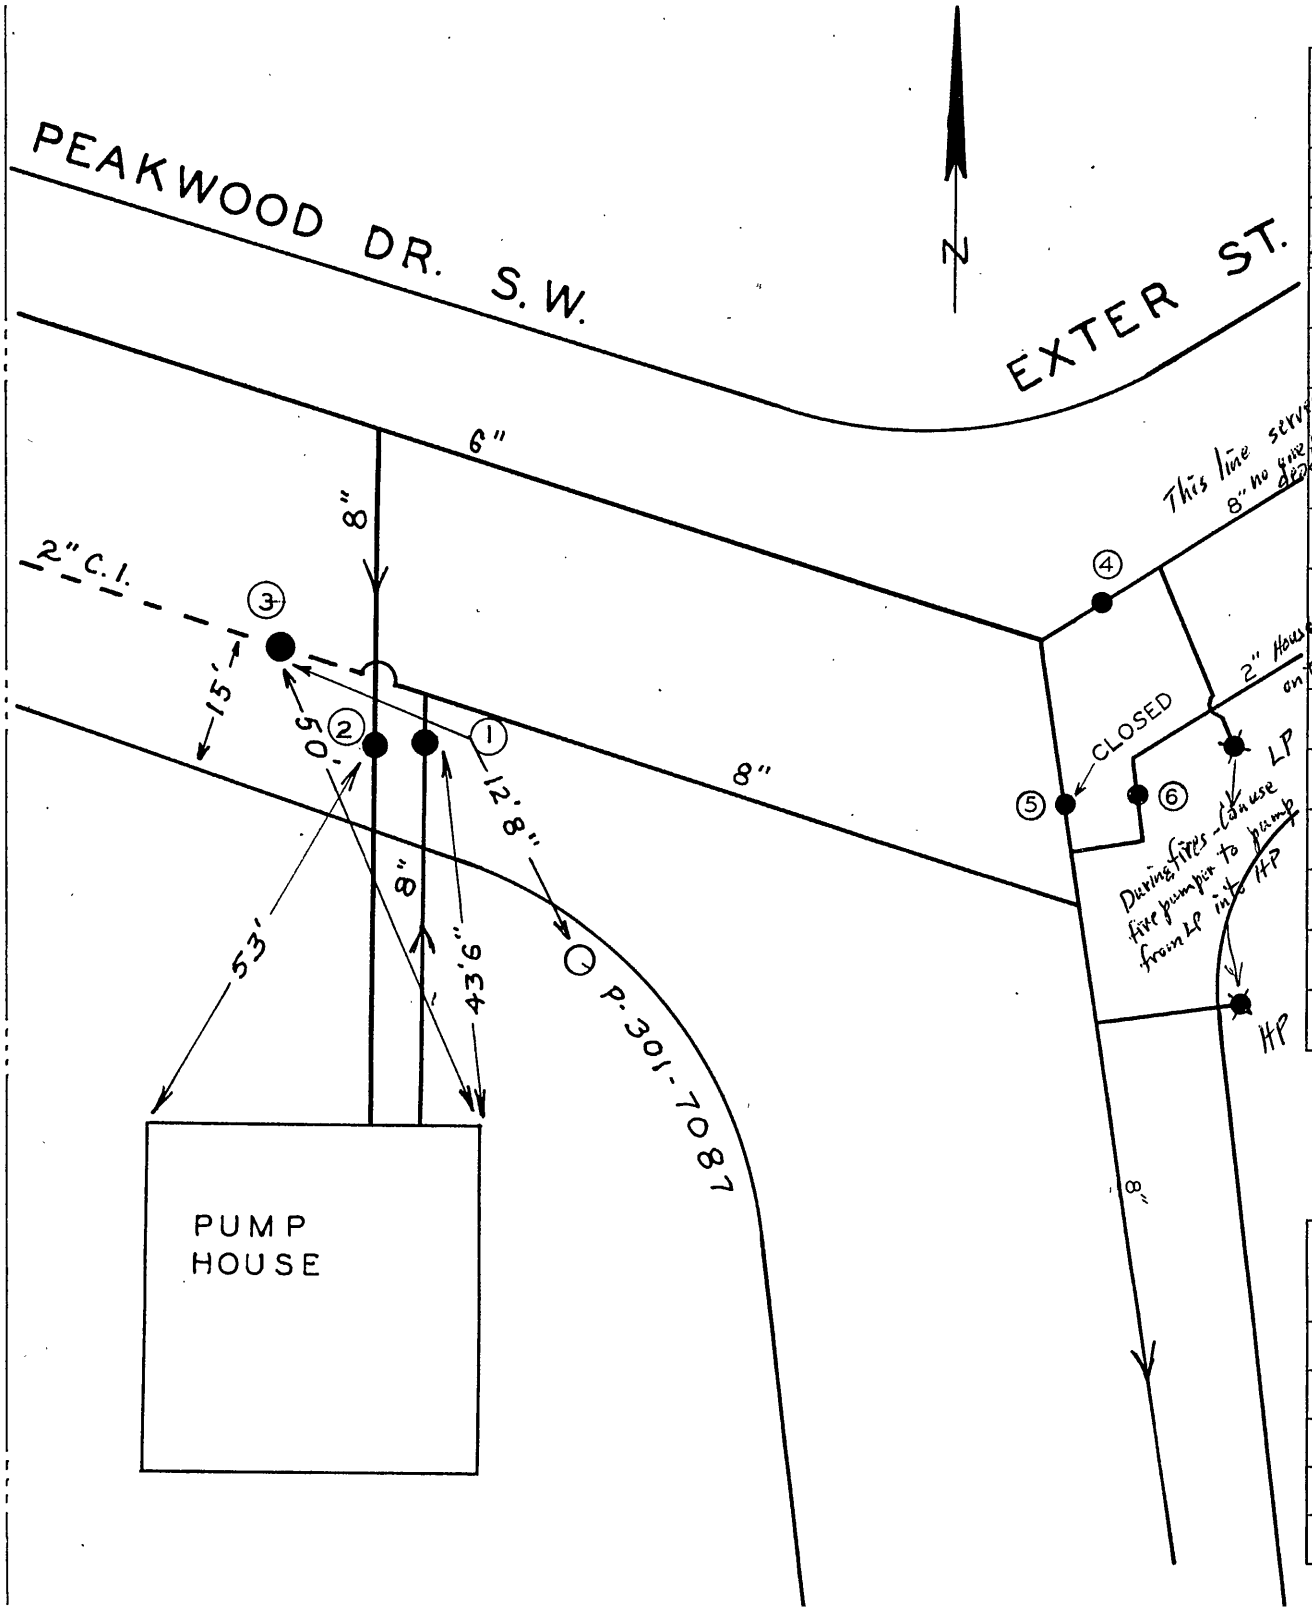

DATE	NO.	SIZE	MAKE	OPEN	TURNS
2-55	1	8"		R	
2-55	2	8"		R	
	3	2"	DARLING	R	7½
	4	8"	MUELLER	R	
	5	8"	DARLING	R	
	6	2"			
	3	60'-W	WPL		

CITY OF ROANOKE—WATER DEPT.

VALVE DIAGRAM

PEAKWOOD PUMP STATION S.W.

SEC. MAP 109

DATE PAGE NO.

"IMPERIAL" TRACING CLOTH K & E CO., N.Y.