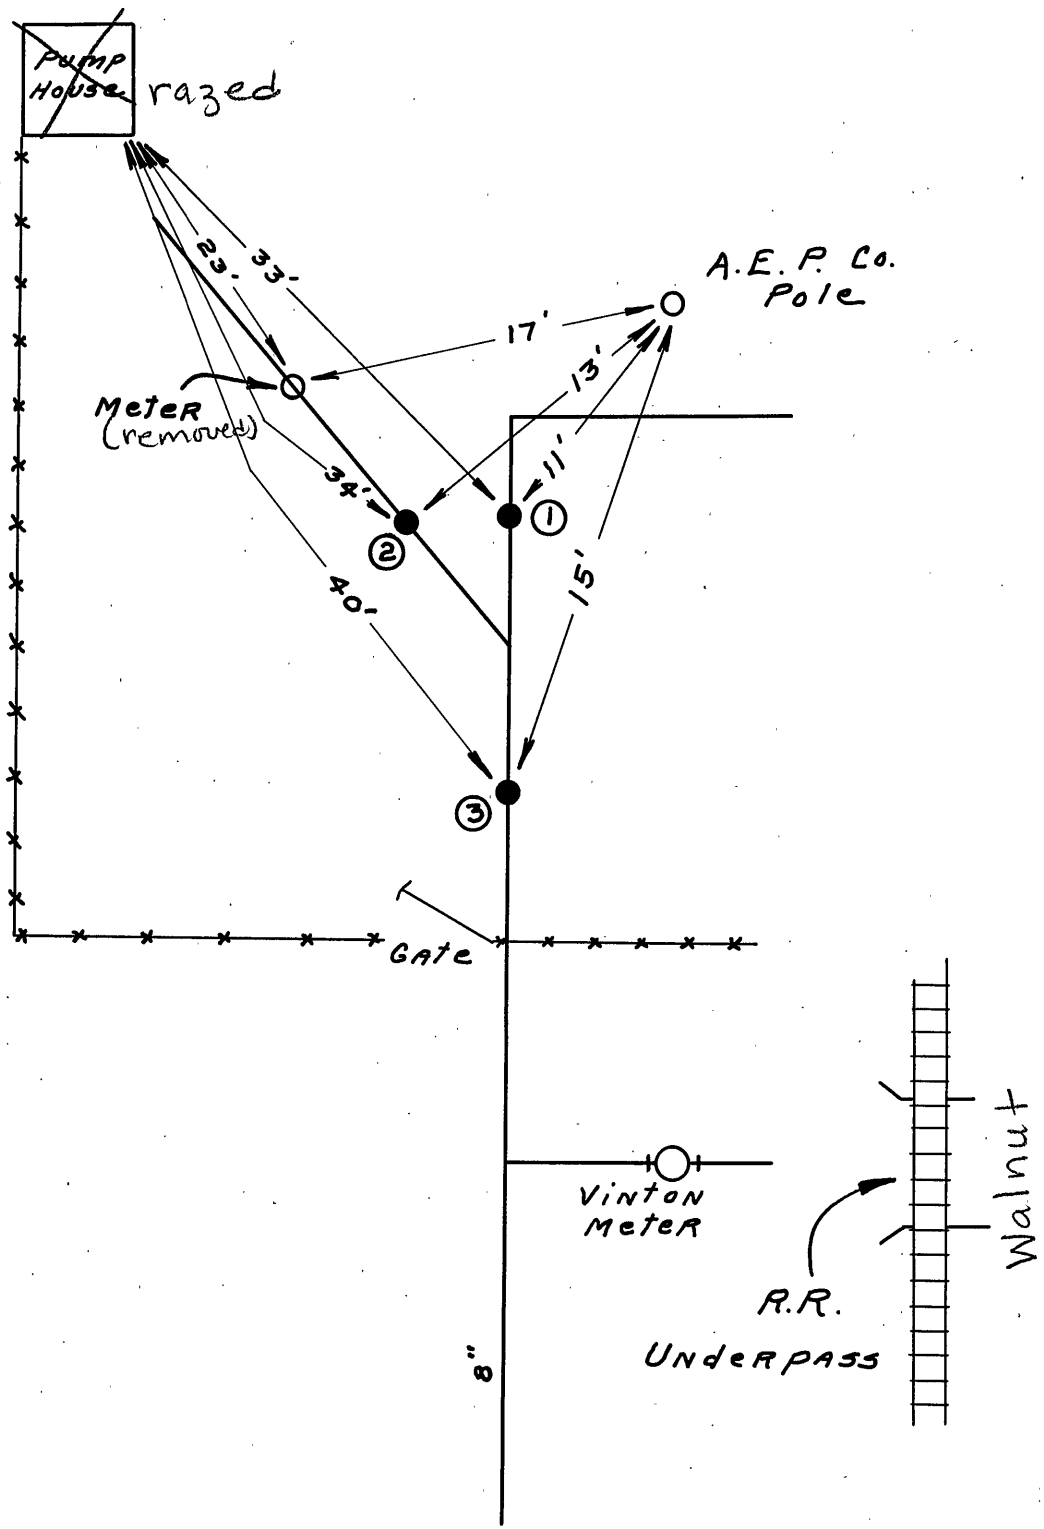

DATE	NO.	SIZE	MAKE	OPEN	TURNS
	1	8"			
	2	8"			
	3	8"			

4th St.

CITY OF ROANOKE—WATER DEPT.

VALVE DIAGRAM

SMITH SPRING

PUMPING STATION N. E.

Gearhart Park—Vinton

SEC. MAP

DATE PAGE NO.

"IMPERIAL" TRACING CLOTH
K & E CO., N. Y.