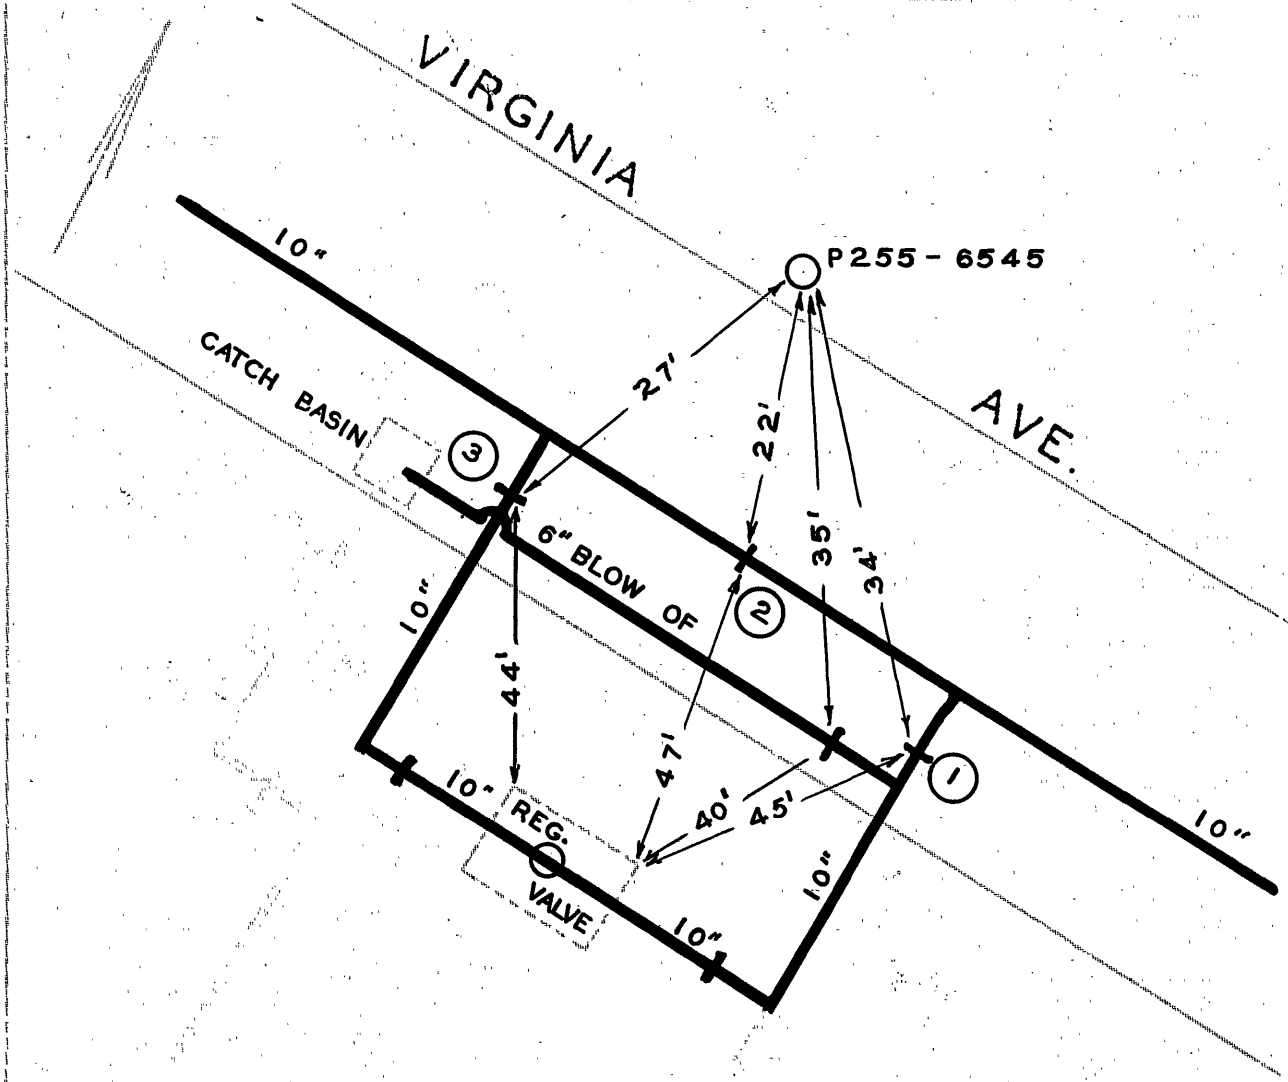

DATE	NO.	SIZE	MARK	OPEN	TURNS
1939	1	10"	DARLING	R	32
1939	2	10"	DARLING	R	32
1939	3	10"	DARLING	R	32

CITY OF ROANOKE--WATER DEPT

VALVE DIAGRAM

VIRGINIA AVE. VINTON

REGULATING STATION

NO 2

SEC. MAP S-13

DATE

PAGE NO. S.E.245.

5/8/43 JHW