




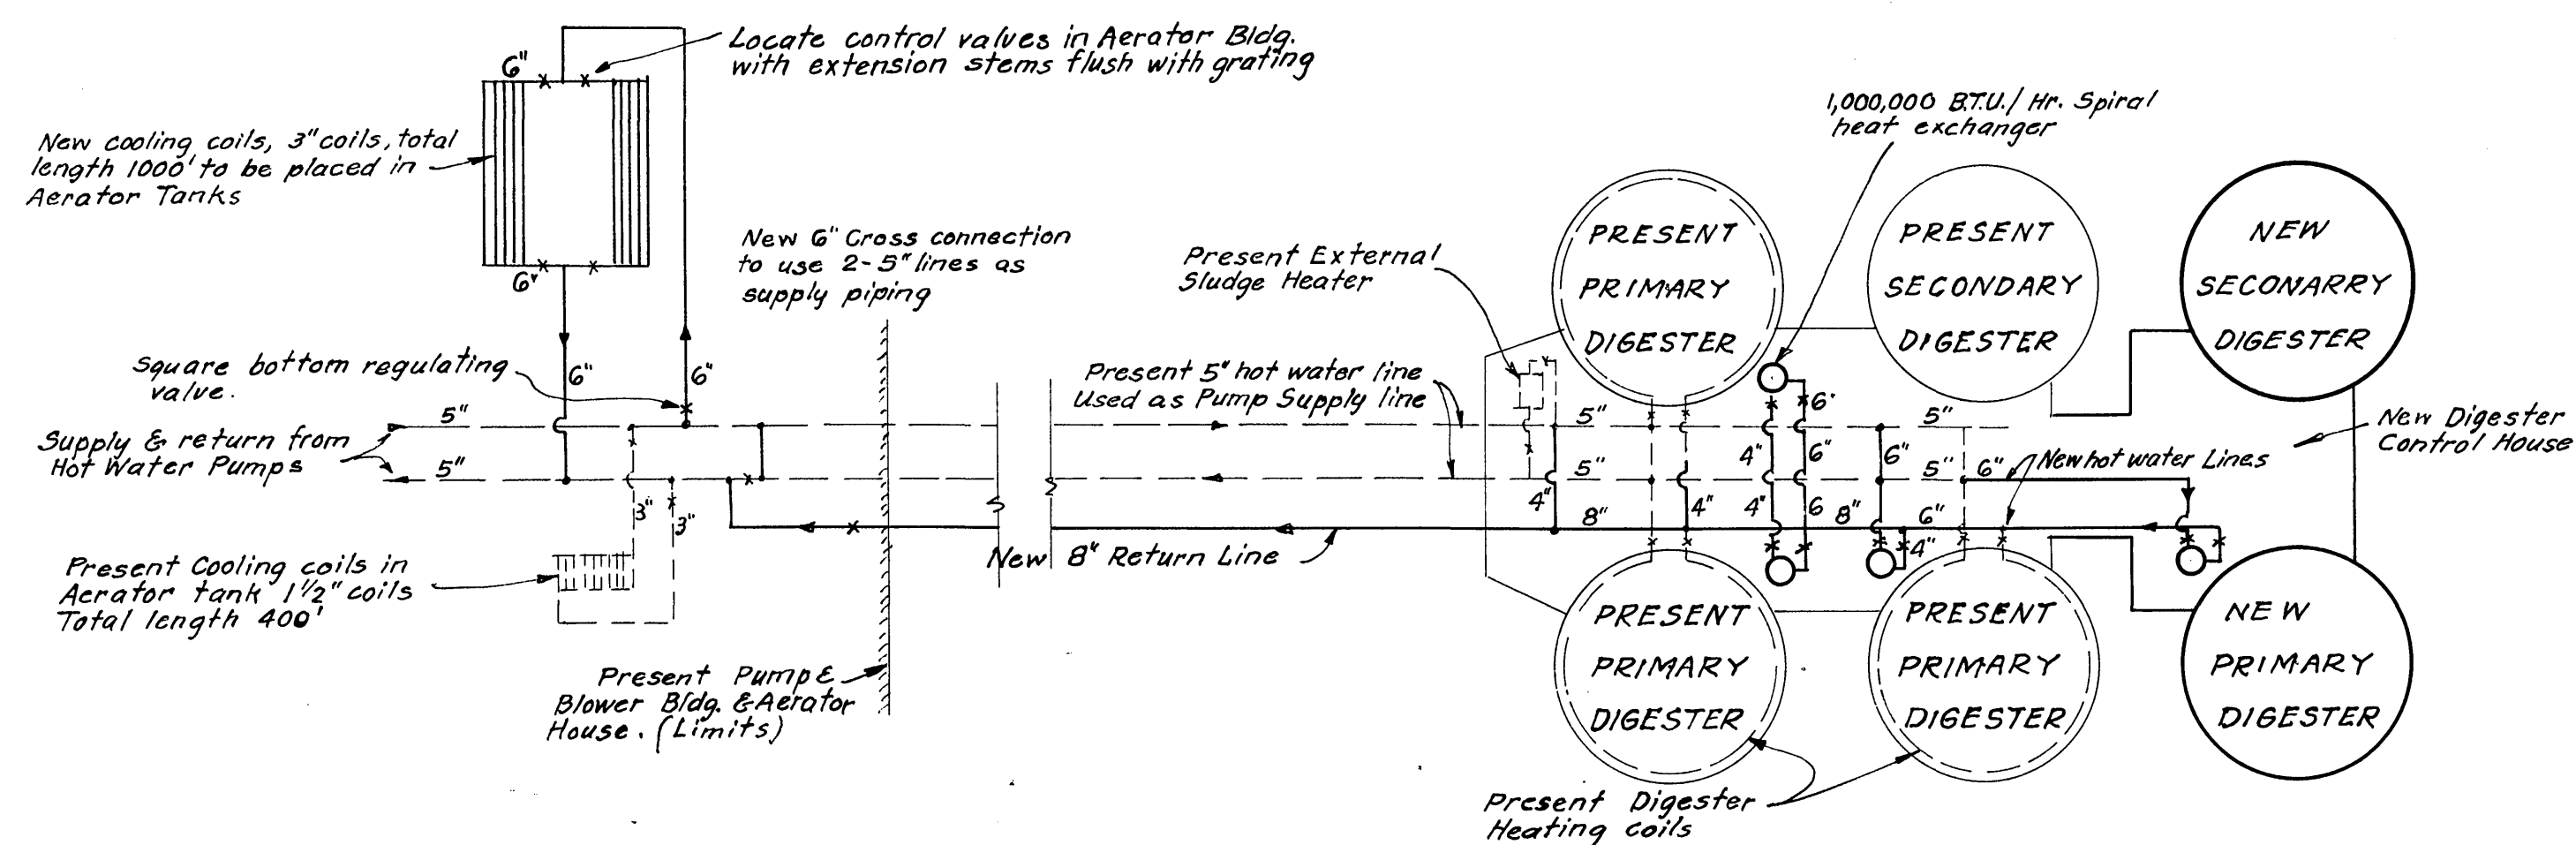


SCHEMATIC DIAGRAM
Proposed Revisions to Present Hot
Water System to Digesters.

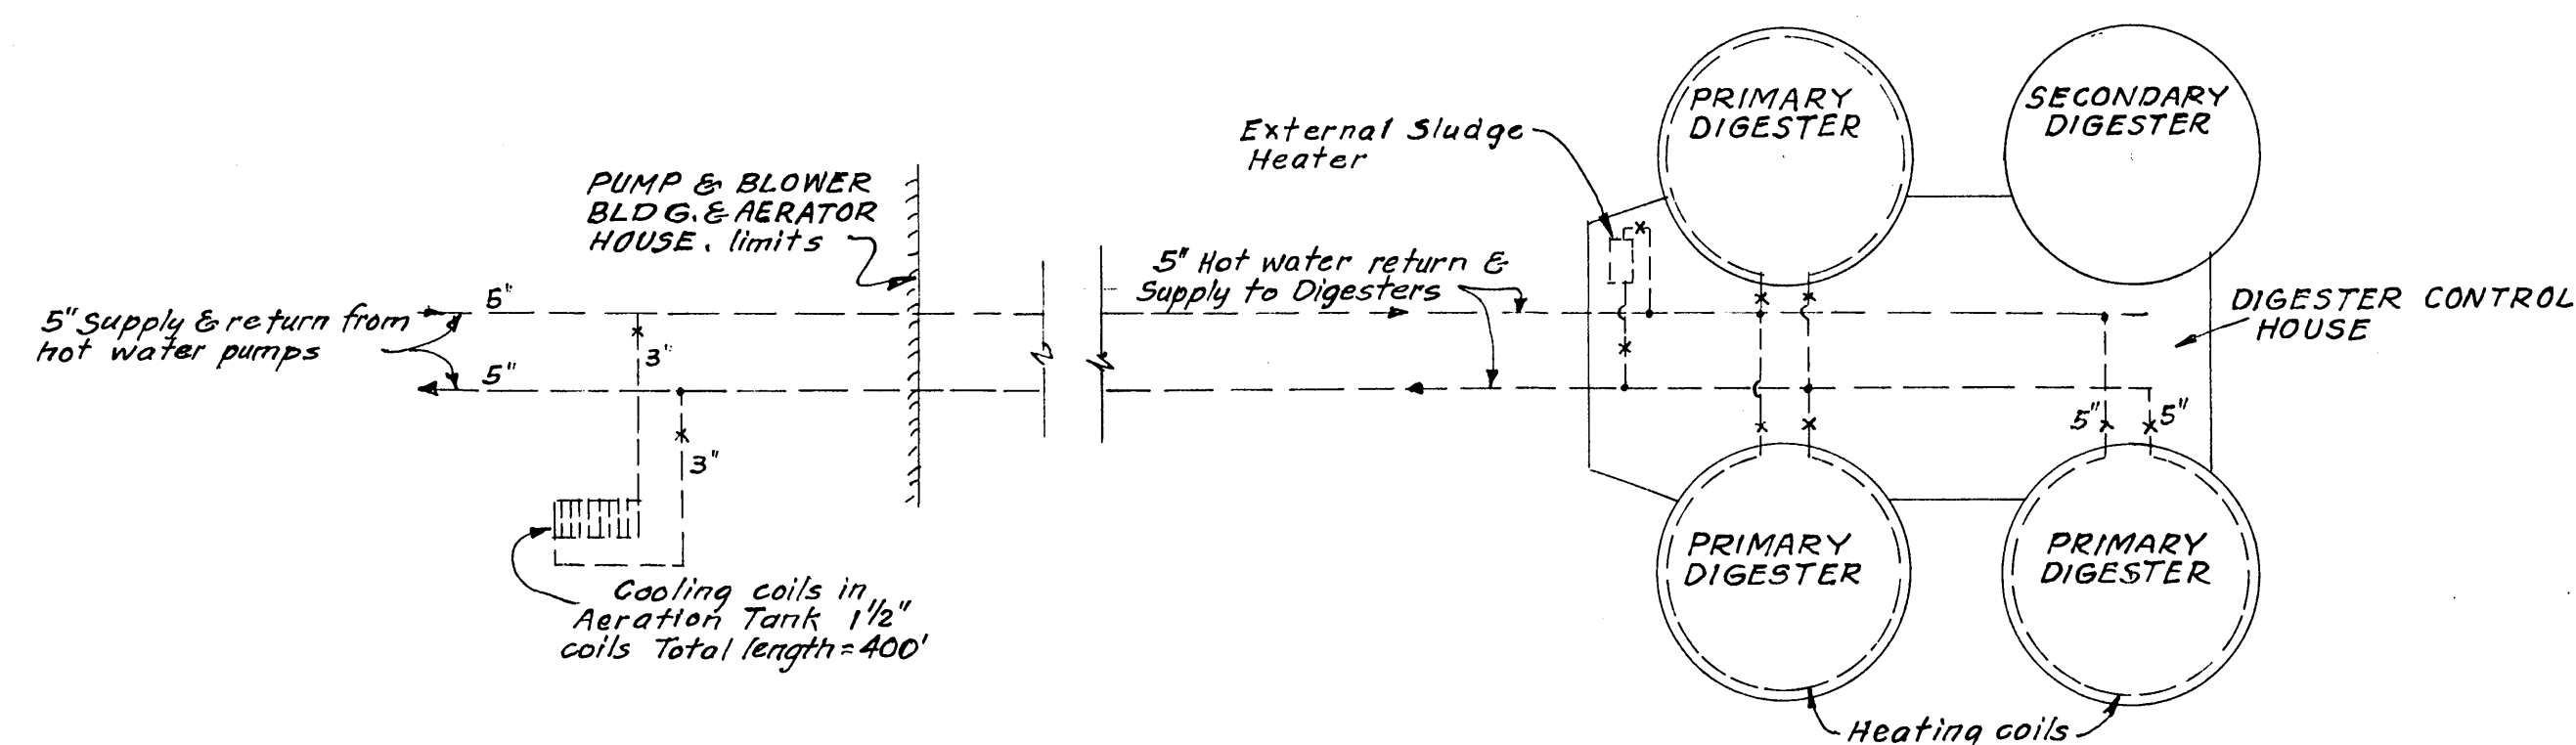


SCHEMATIC DIAGRAM
PRESENT HOT WATER SYSTEM
TO DIGESTERS

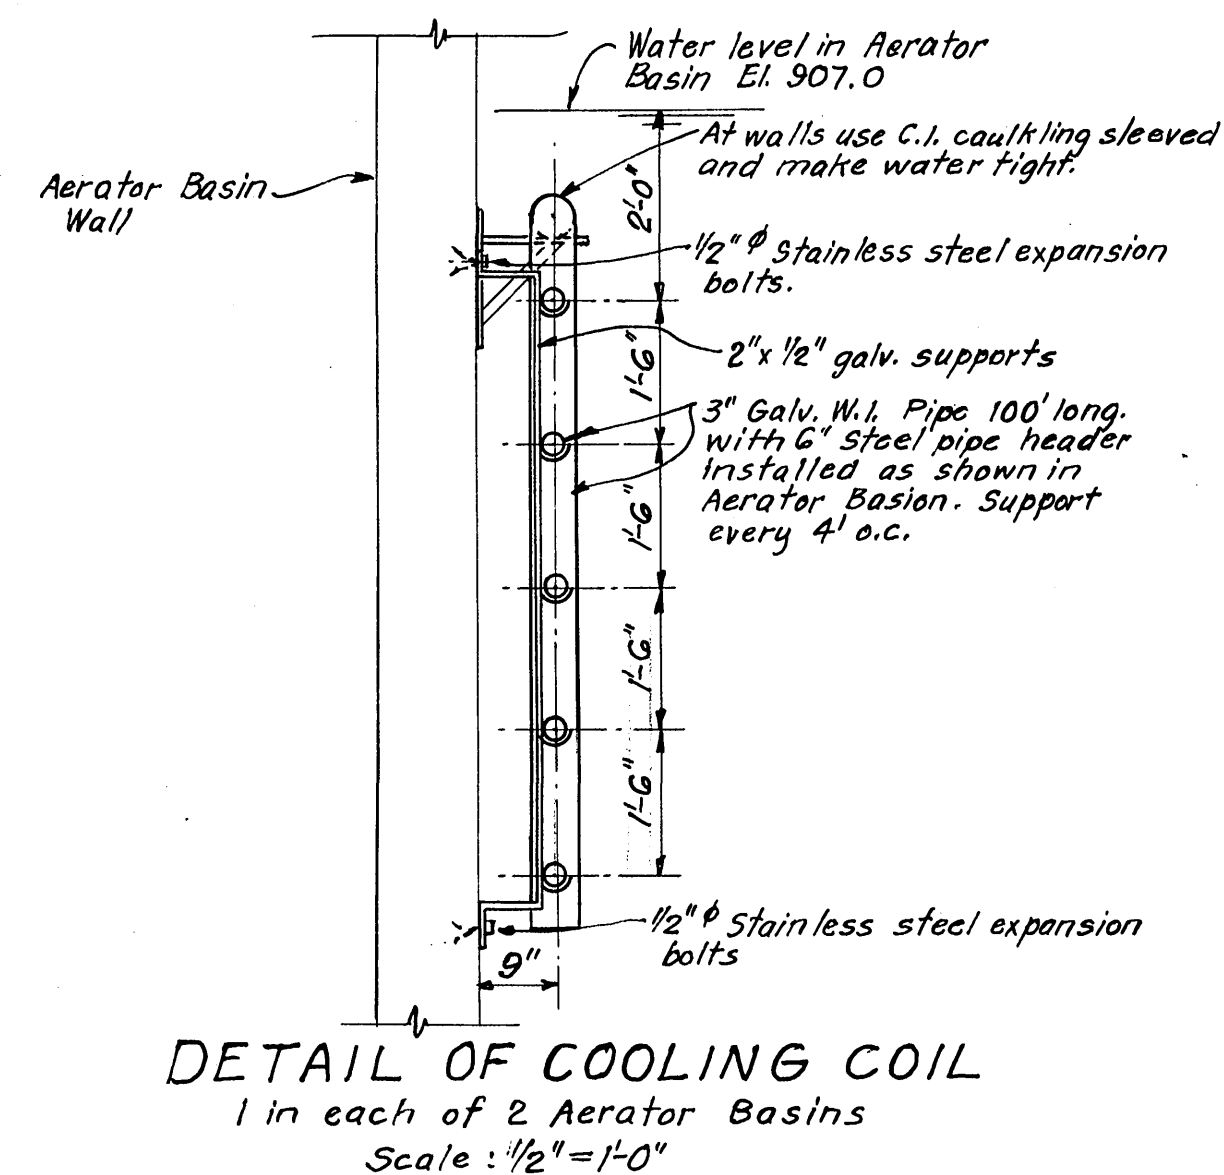

DETAIL OF COOLING COIL
1 in each of 2 Aerator Basins
Scale: 1/2" = 1'-0"

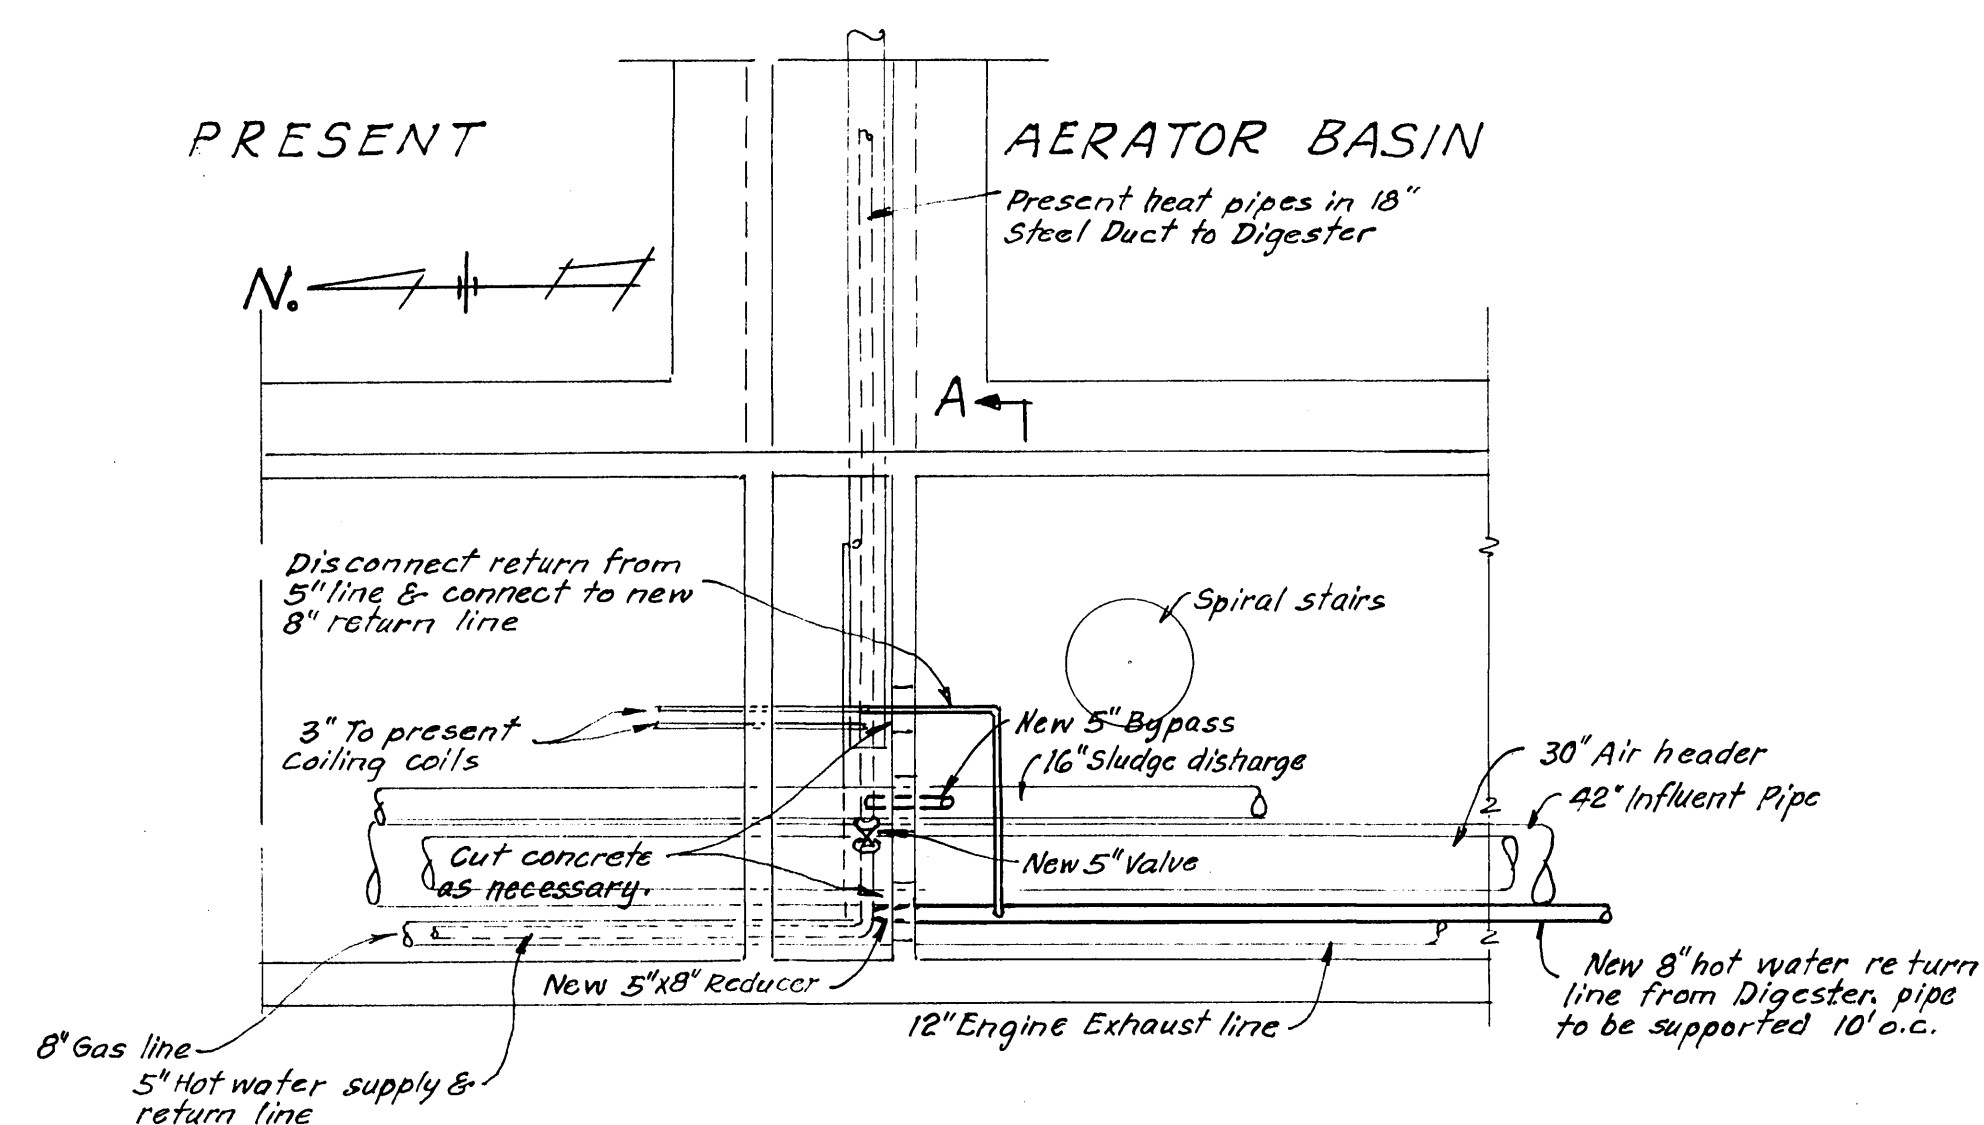

PLAN OF HOT WATER PIPING CONNECTIONS
Scale: 1/4" = 1'-0"

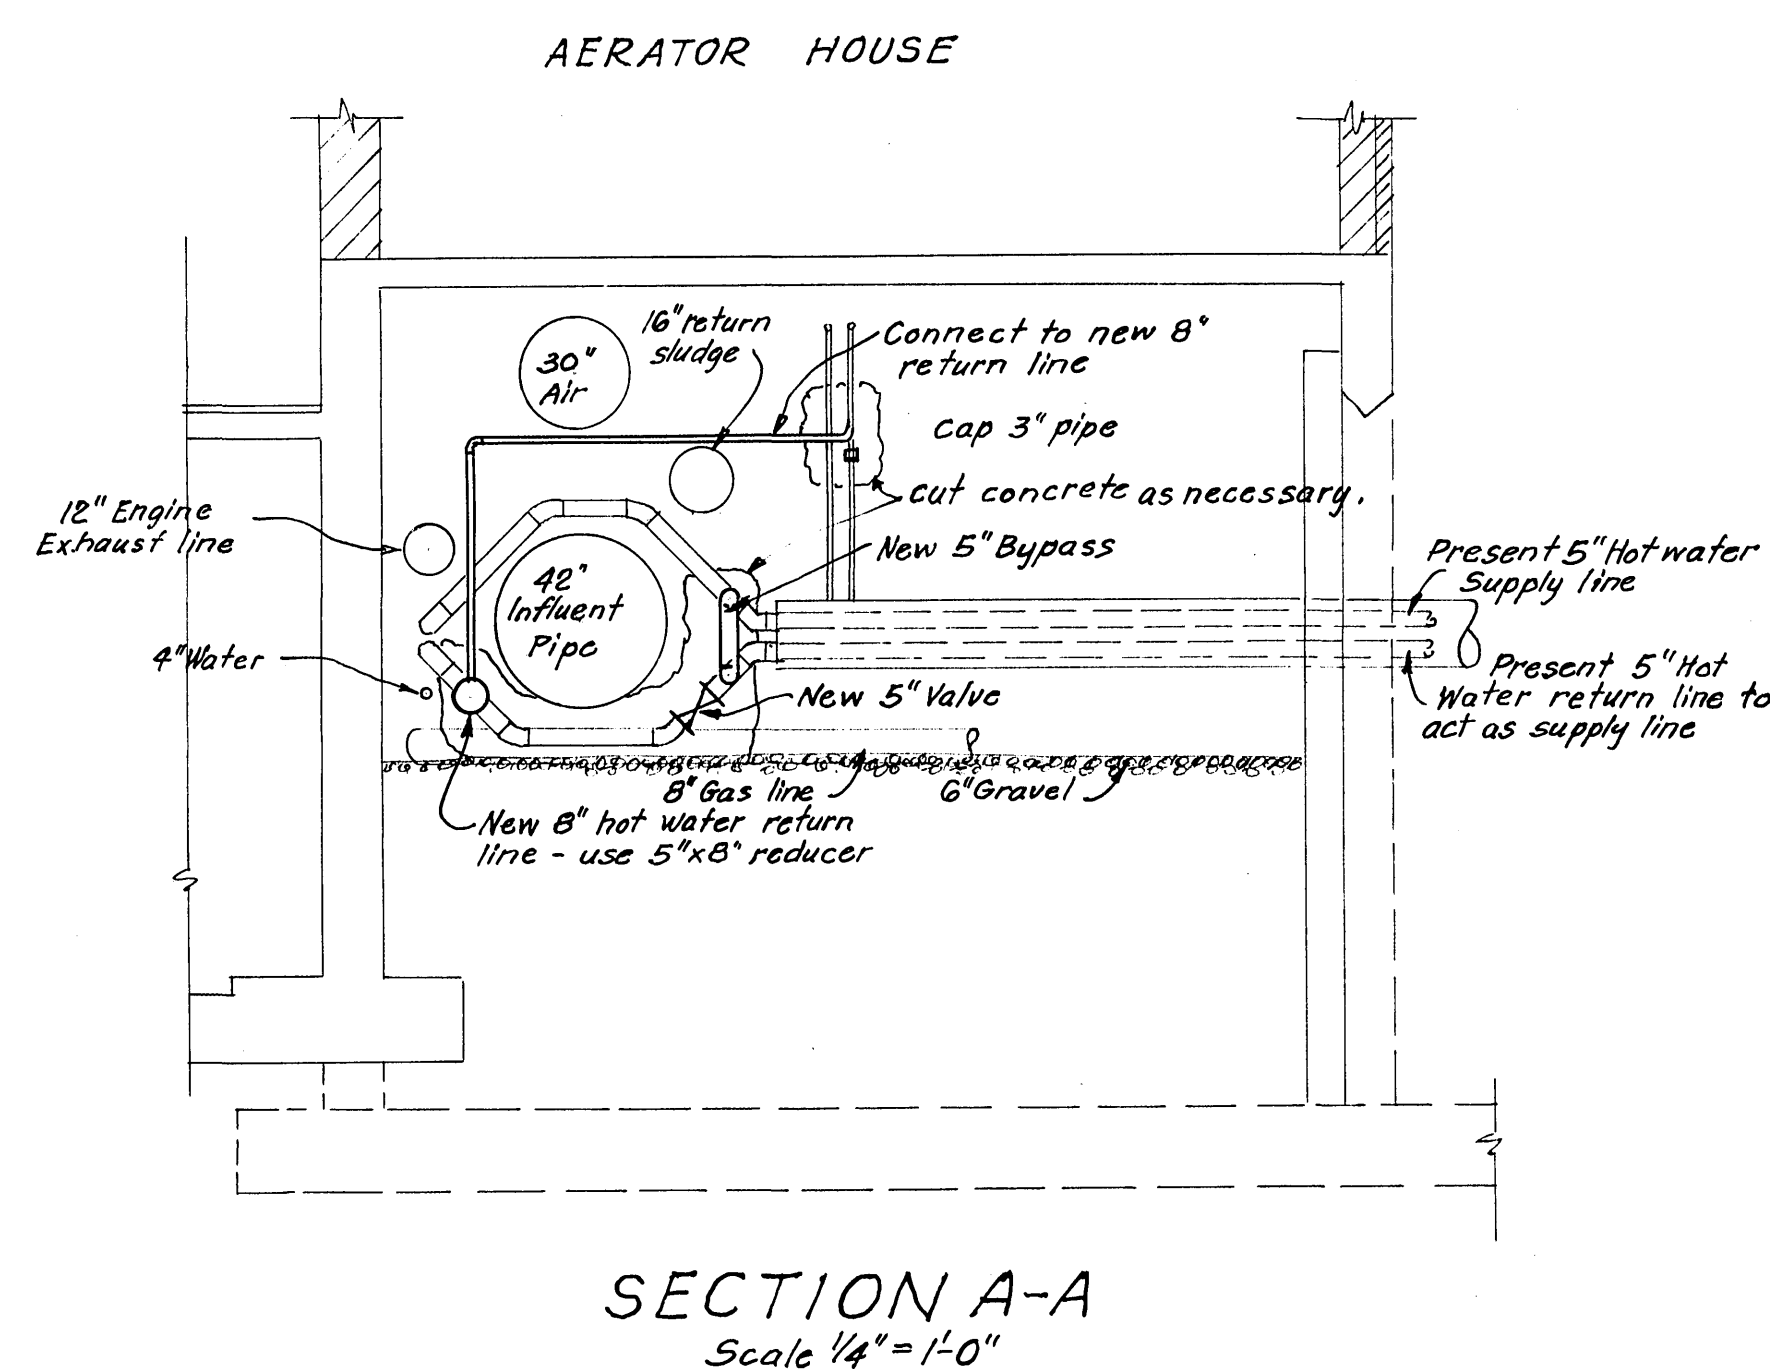

SECTION A-A
Scale 1/4" = 1'-0"