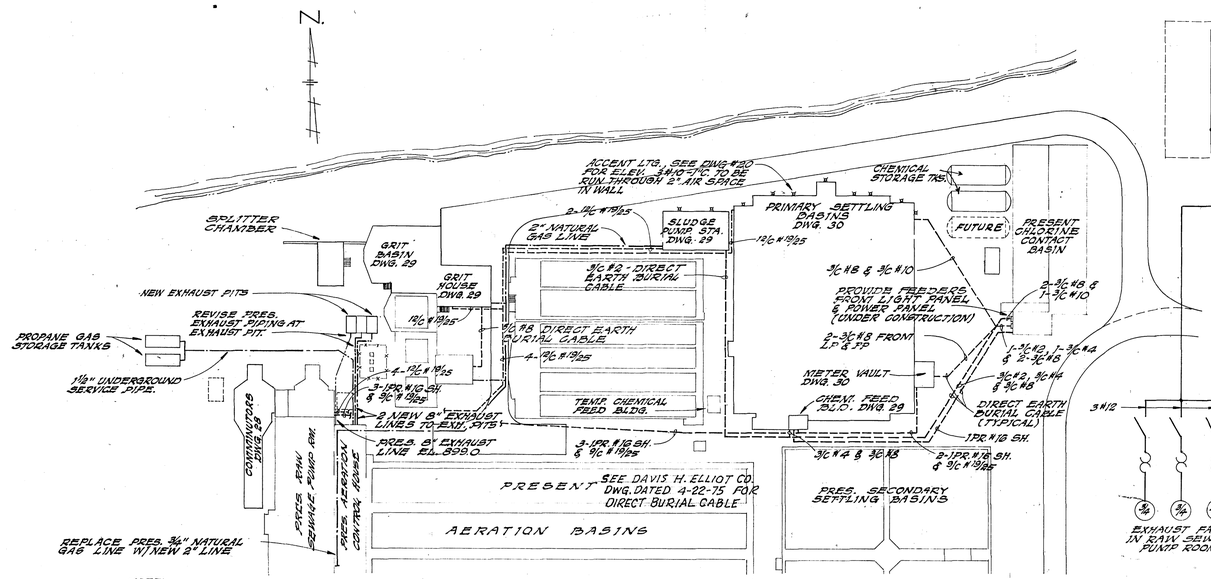

NOTE:
ALL CABLES SHOWN ARE DIRECT BURIAL

PLOT PLAN
SCALE: 1" = 50'

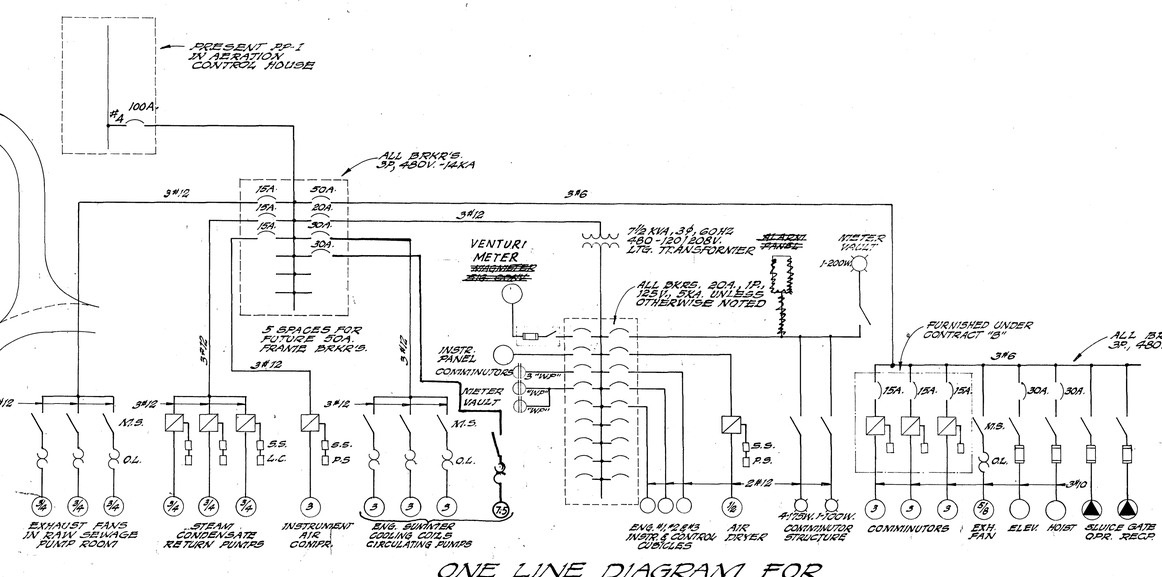

ONE LINE DIAGRAM FOR
PUMP ROOM - COMMINUTOR STRUCTURE & AERATION CONTROL HOUSE

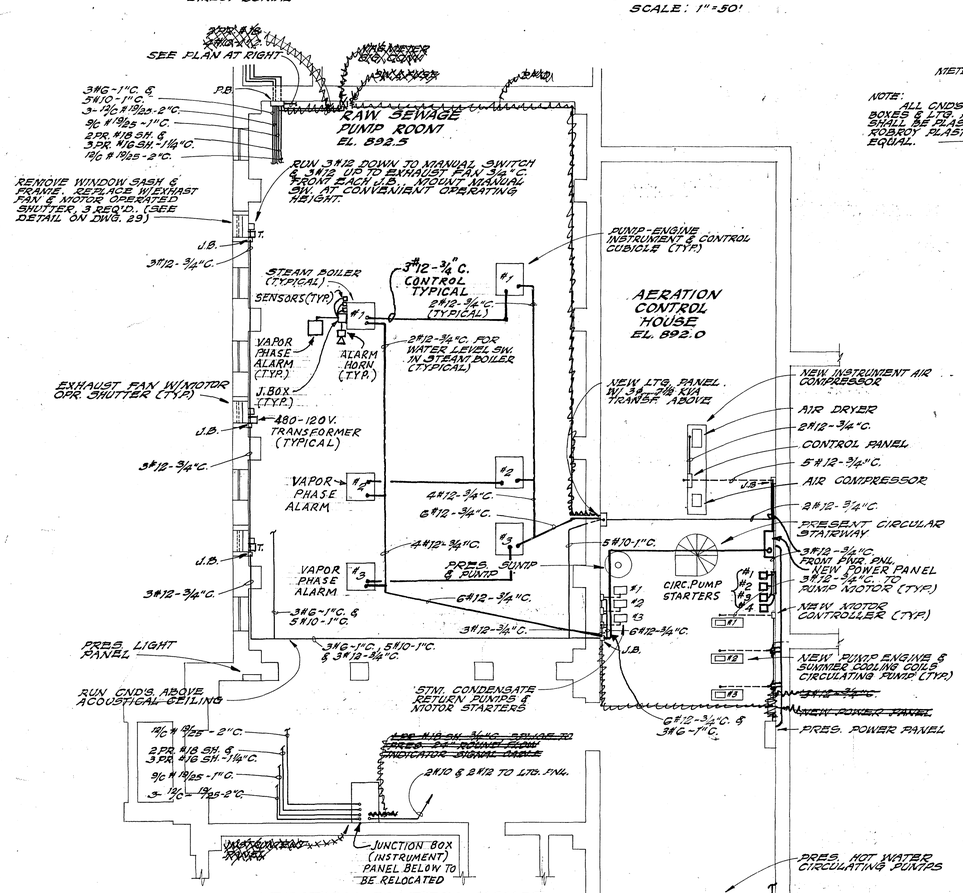

PUMP RM. & AERATION CONTROL HOUSE
POWER & LIGHT PLAN
SCALE: 1/8" = 1'-0"

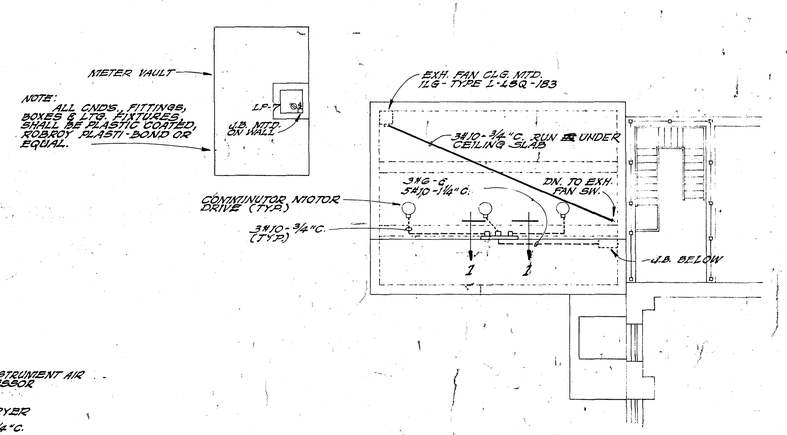

COMMINUTORS EL. 903.83
POWER PLAN
SCALE: 1/8" = 1'-0"

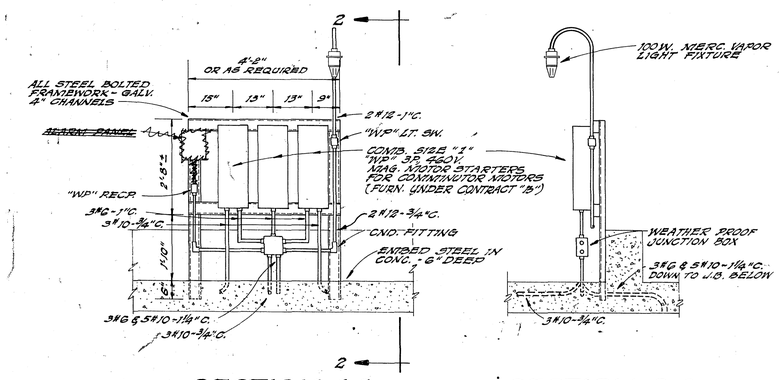

SECTION 1-1
SCALE: 1/2" = 1'-0"

SECTION 2-2
SCALE: 1/2" = 1'-0

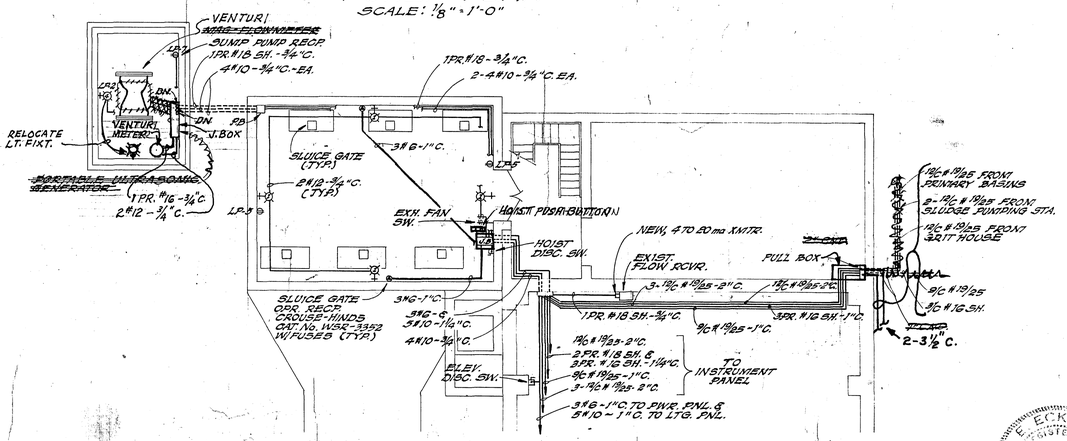

COMMINUTORS EL. 892.50
POWER & LIGHT PLAN
SCALE: 1/8" = 1'-0"

NOTE:
ONE ALARM PANEL ~~TYP.~~ FOR THE ~~COMMINUTORS~~, GRIT BASIN AND 3 FOR THE PRIMARY BASINS WILL BE FURNISHED UNDER CONTRACT "B", AND SHALL BE INSTALLED AND WIRED BY THIS CONTRACTOR.

AS BUILT (28)

CONTR. "C"

ADDITIONS TO SEWAGE TREATMENT PLANT
ROANOKE, VIRGINIA

ELECTRICAL LIGHT & POWER

ALVORD, BURDICK & HOWSON
ENGINEERS — CHICAGO

1973

D. E. ECKMANN
REGISTERED
No. 03991
STATE OF VIRGINIA
PROFESSIONAL ENGINEER