



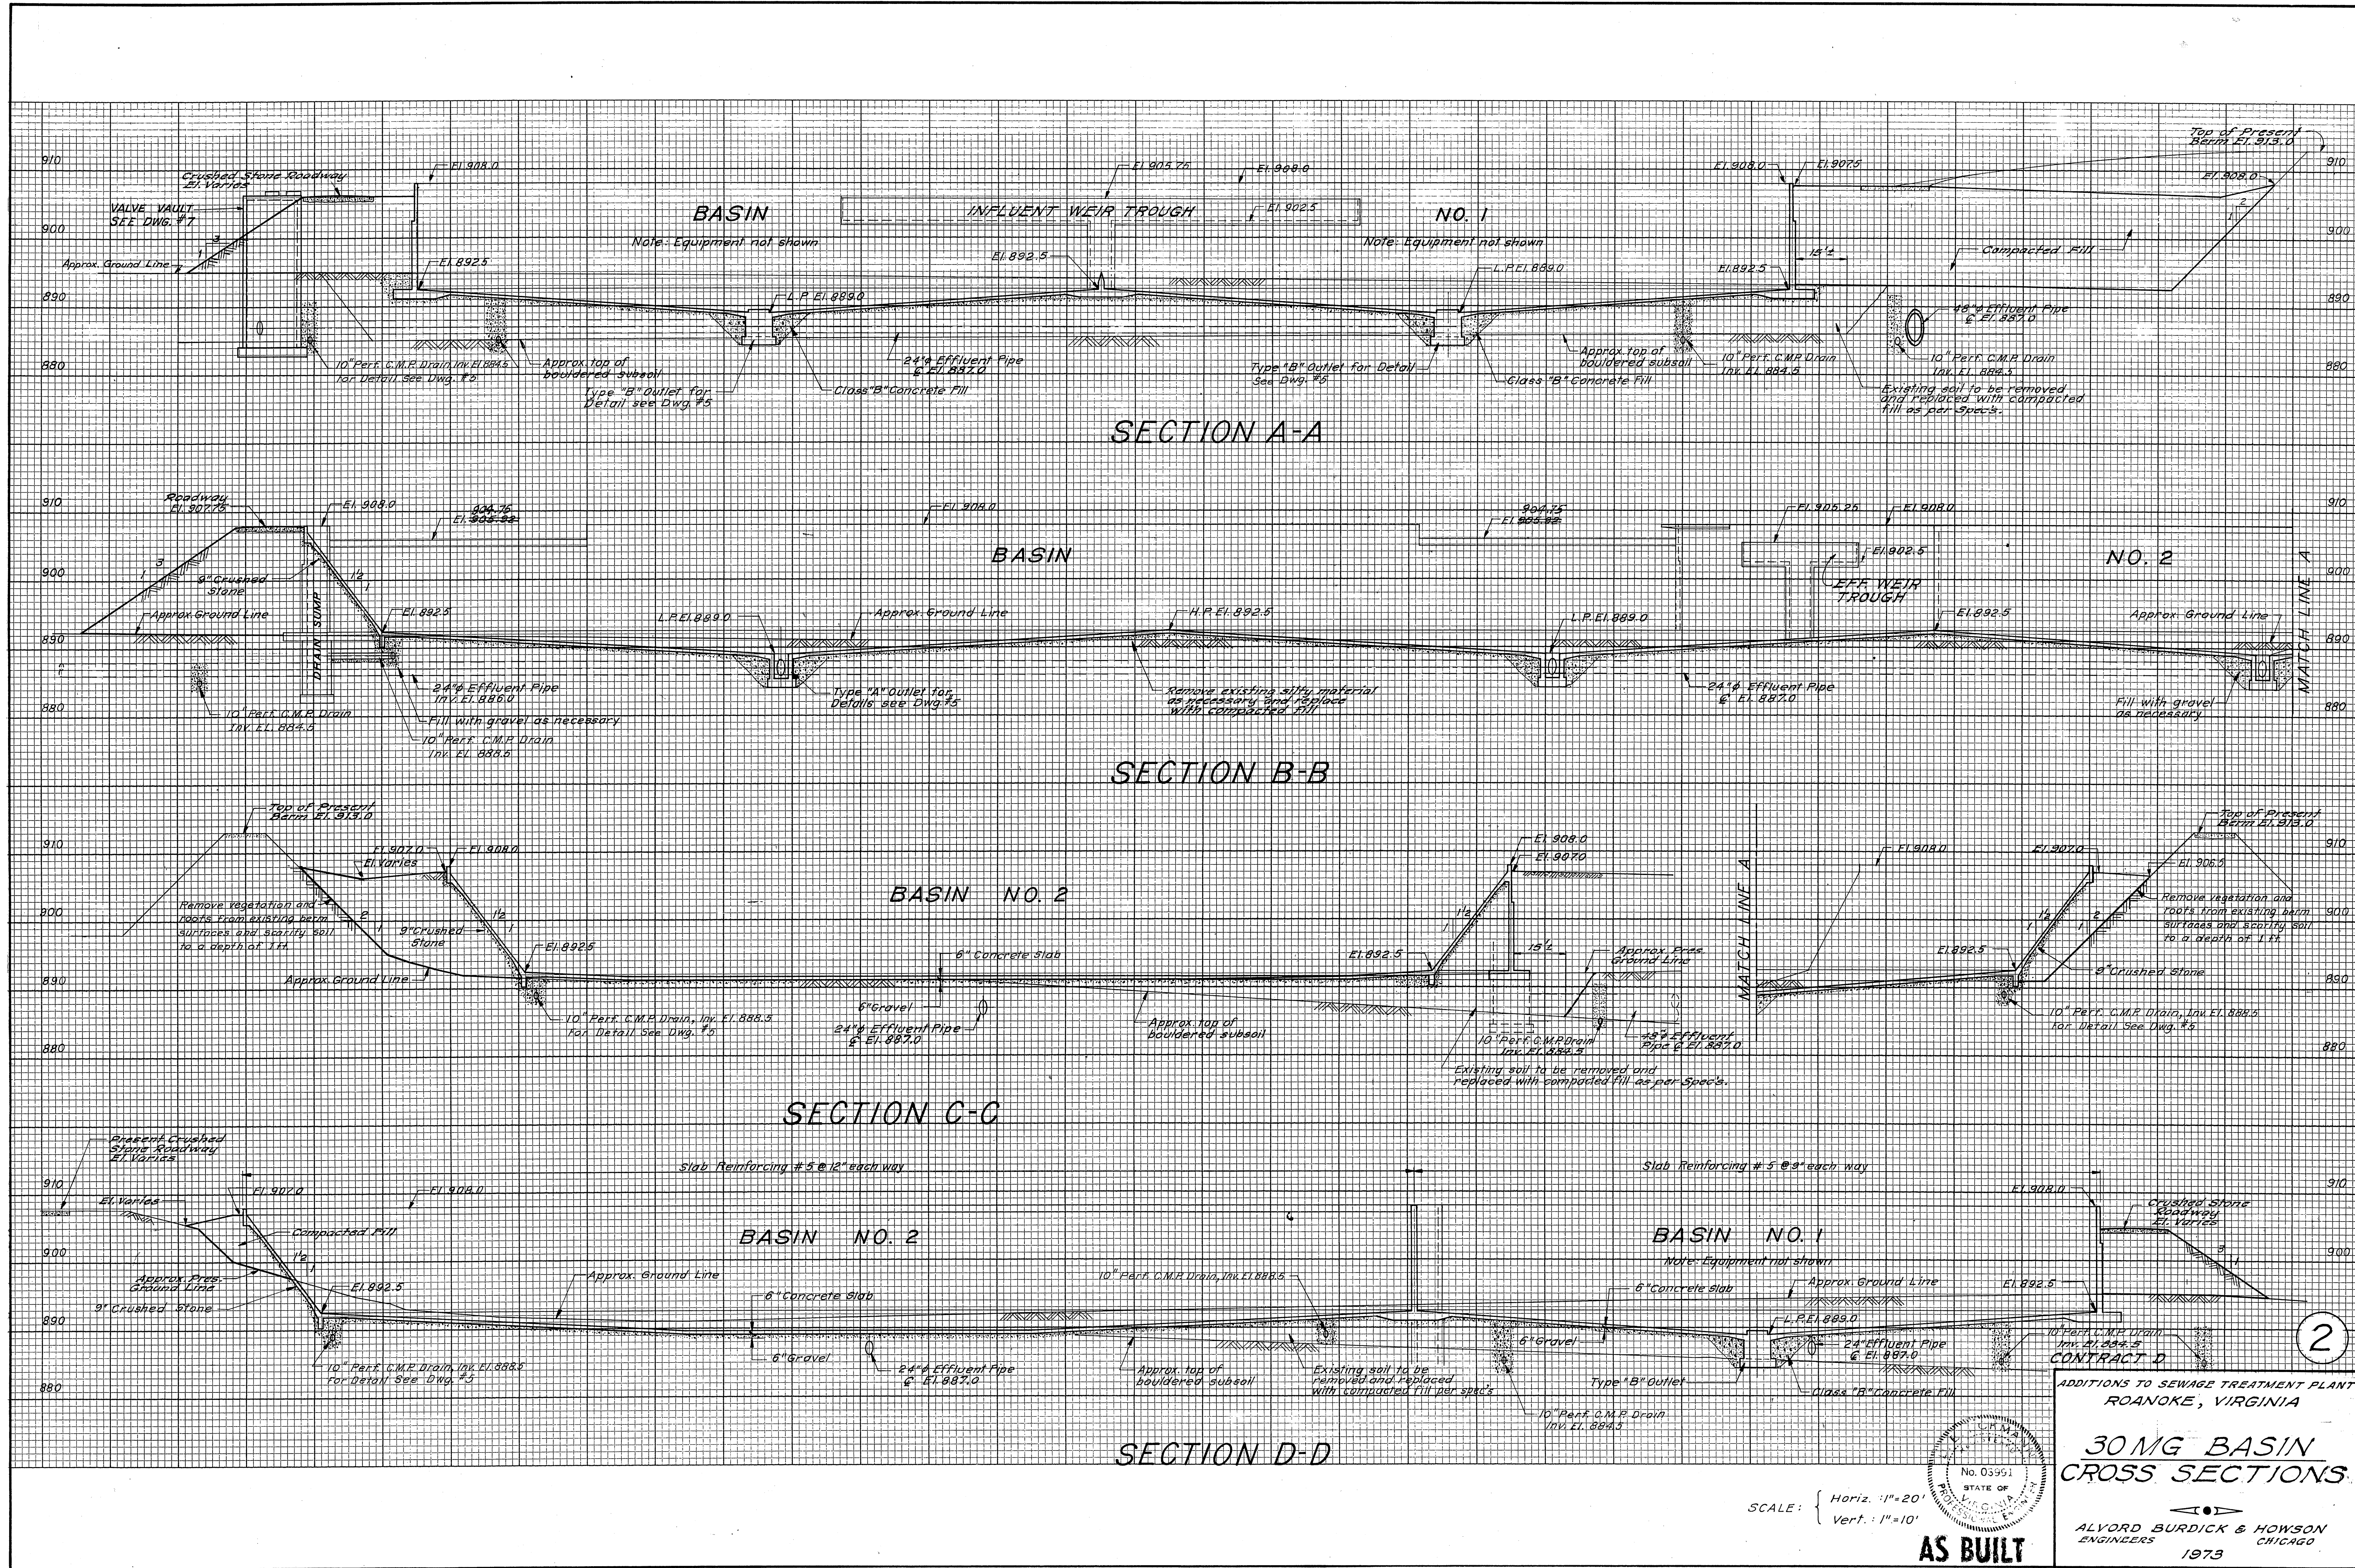

SCALE: { Horiz. 1"=20'
Vert. 1"=10'

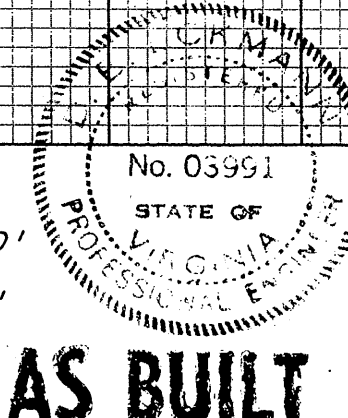

CONTRACT D
ADDITIONS TO SEWAGE TREATMENT PLANT
ROANOKE, VIRGINIA
**30 MG BASIN
CROSS SECTIONS**
ALYDOR BURDICK & HOWSON
ENGINEERS CHICAGO
1973