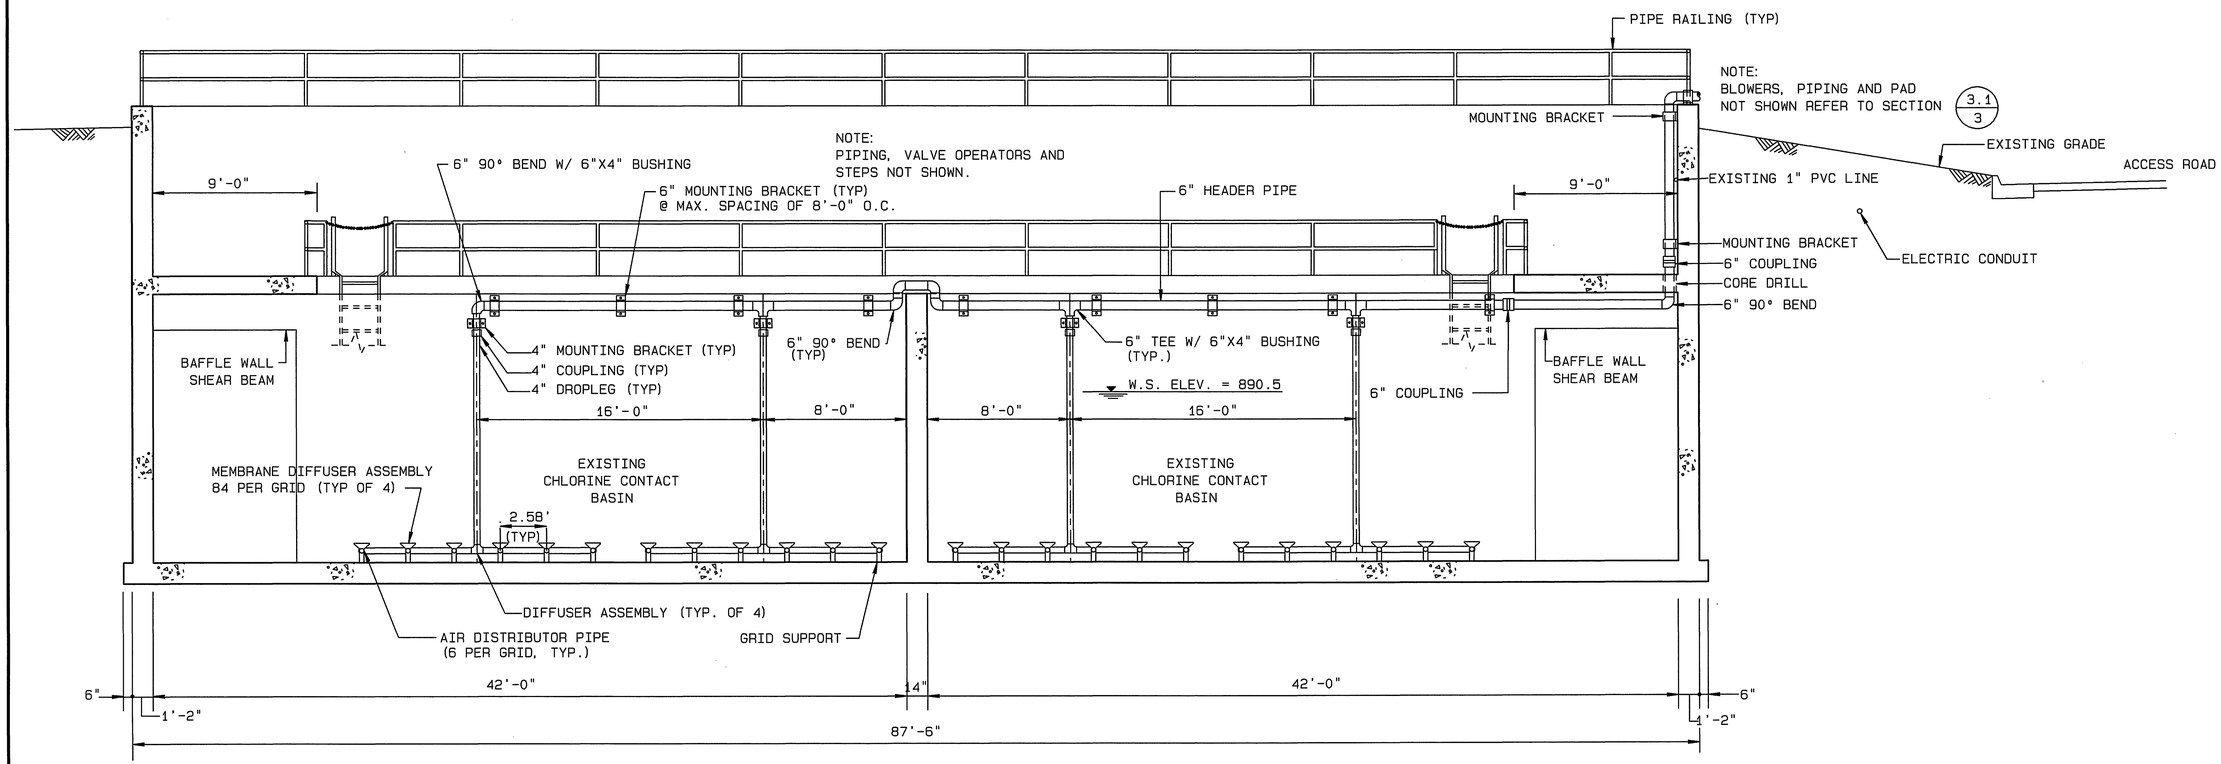

SECTION 5.3/3

SCALE: 1/4" = 1'-0"

RECORD DRAWING

Mattern & Craig
CONSULTING ENGINEERS - SURVEYORS

DESIGNED: BCC
DRAWN: TAM
CHECKED: SWH

COMMONWEALTH OF VIRGINIA
STEWART W. HUBBELL
NO. 07420
PROFESSIONAL ENGINEER

REVISION	DATE	DESCRIPTION	BY	APP.

DATE
NOVEMBER 1994
COMM.
1367

EFFLUENT REAERATION PROJECT
SECTION
ROANOKE WATER POLLUTION CONTROL PLANT
CITY OF ROANOKE, VIRGINIA

SCALE: AS SHOWN

6454

SHEET
5

DRAWING #5