


- LEGEND**
- C.B. Catch Basin
 - Y.D. Yard Drain
 - R.D. Road Drain
 - R.C. Reinforced Concrete
 - C.I. Cast Iron
 - C.M.P. Corrugated Metal Pipe
 - F.G. Finished Grade
 - S.B. Soil Borings

NOTE

1. Protect all Trees along Present River Bank
2. New grades at Shore shall be adjusted to meet Pres Grade at the Tree
3. Provide flared end sections for all Culverts & Drains

SCALE:
1" = 30'

ROANOKE RIVER

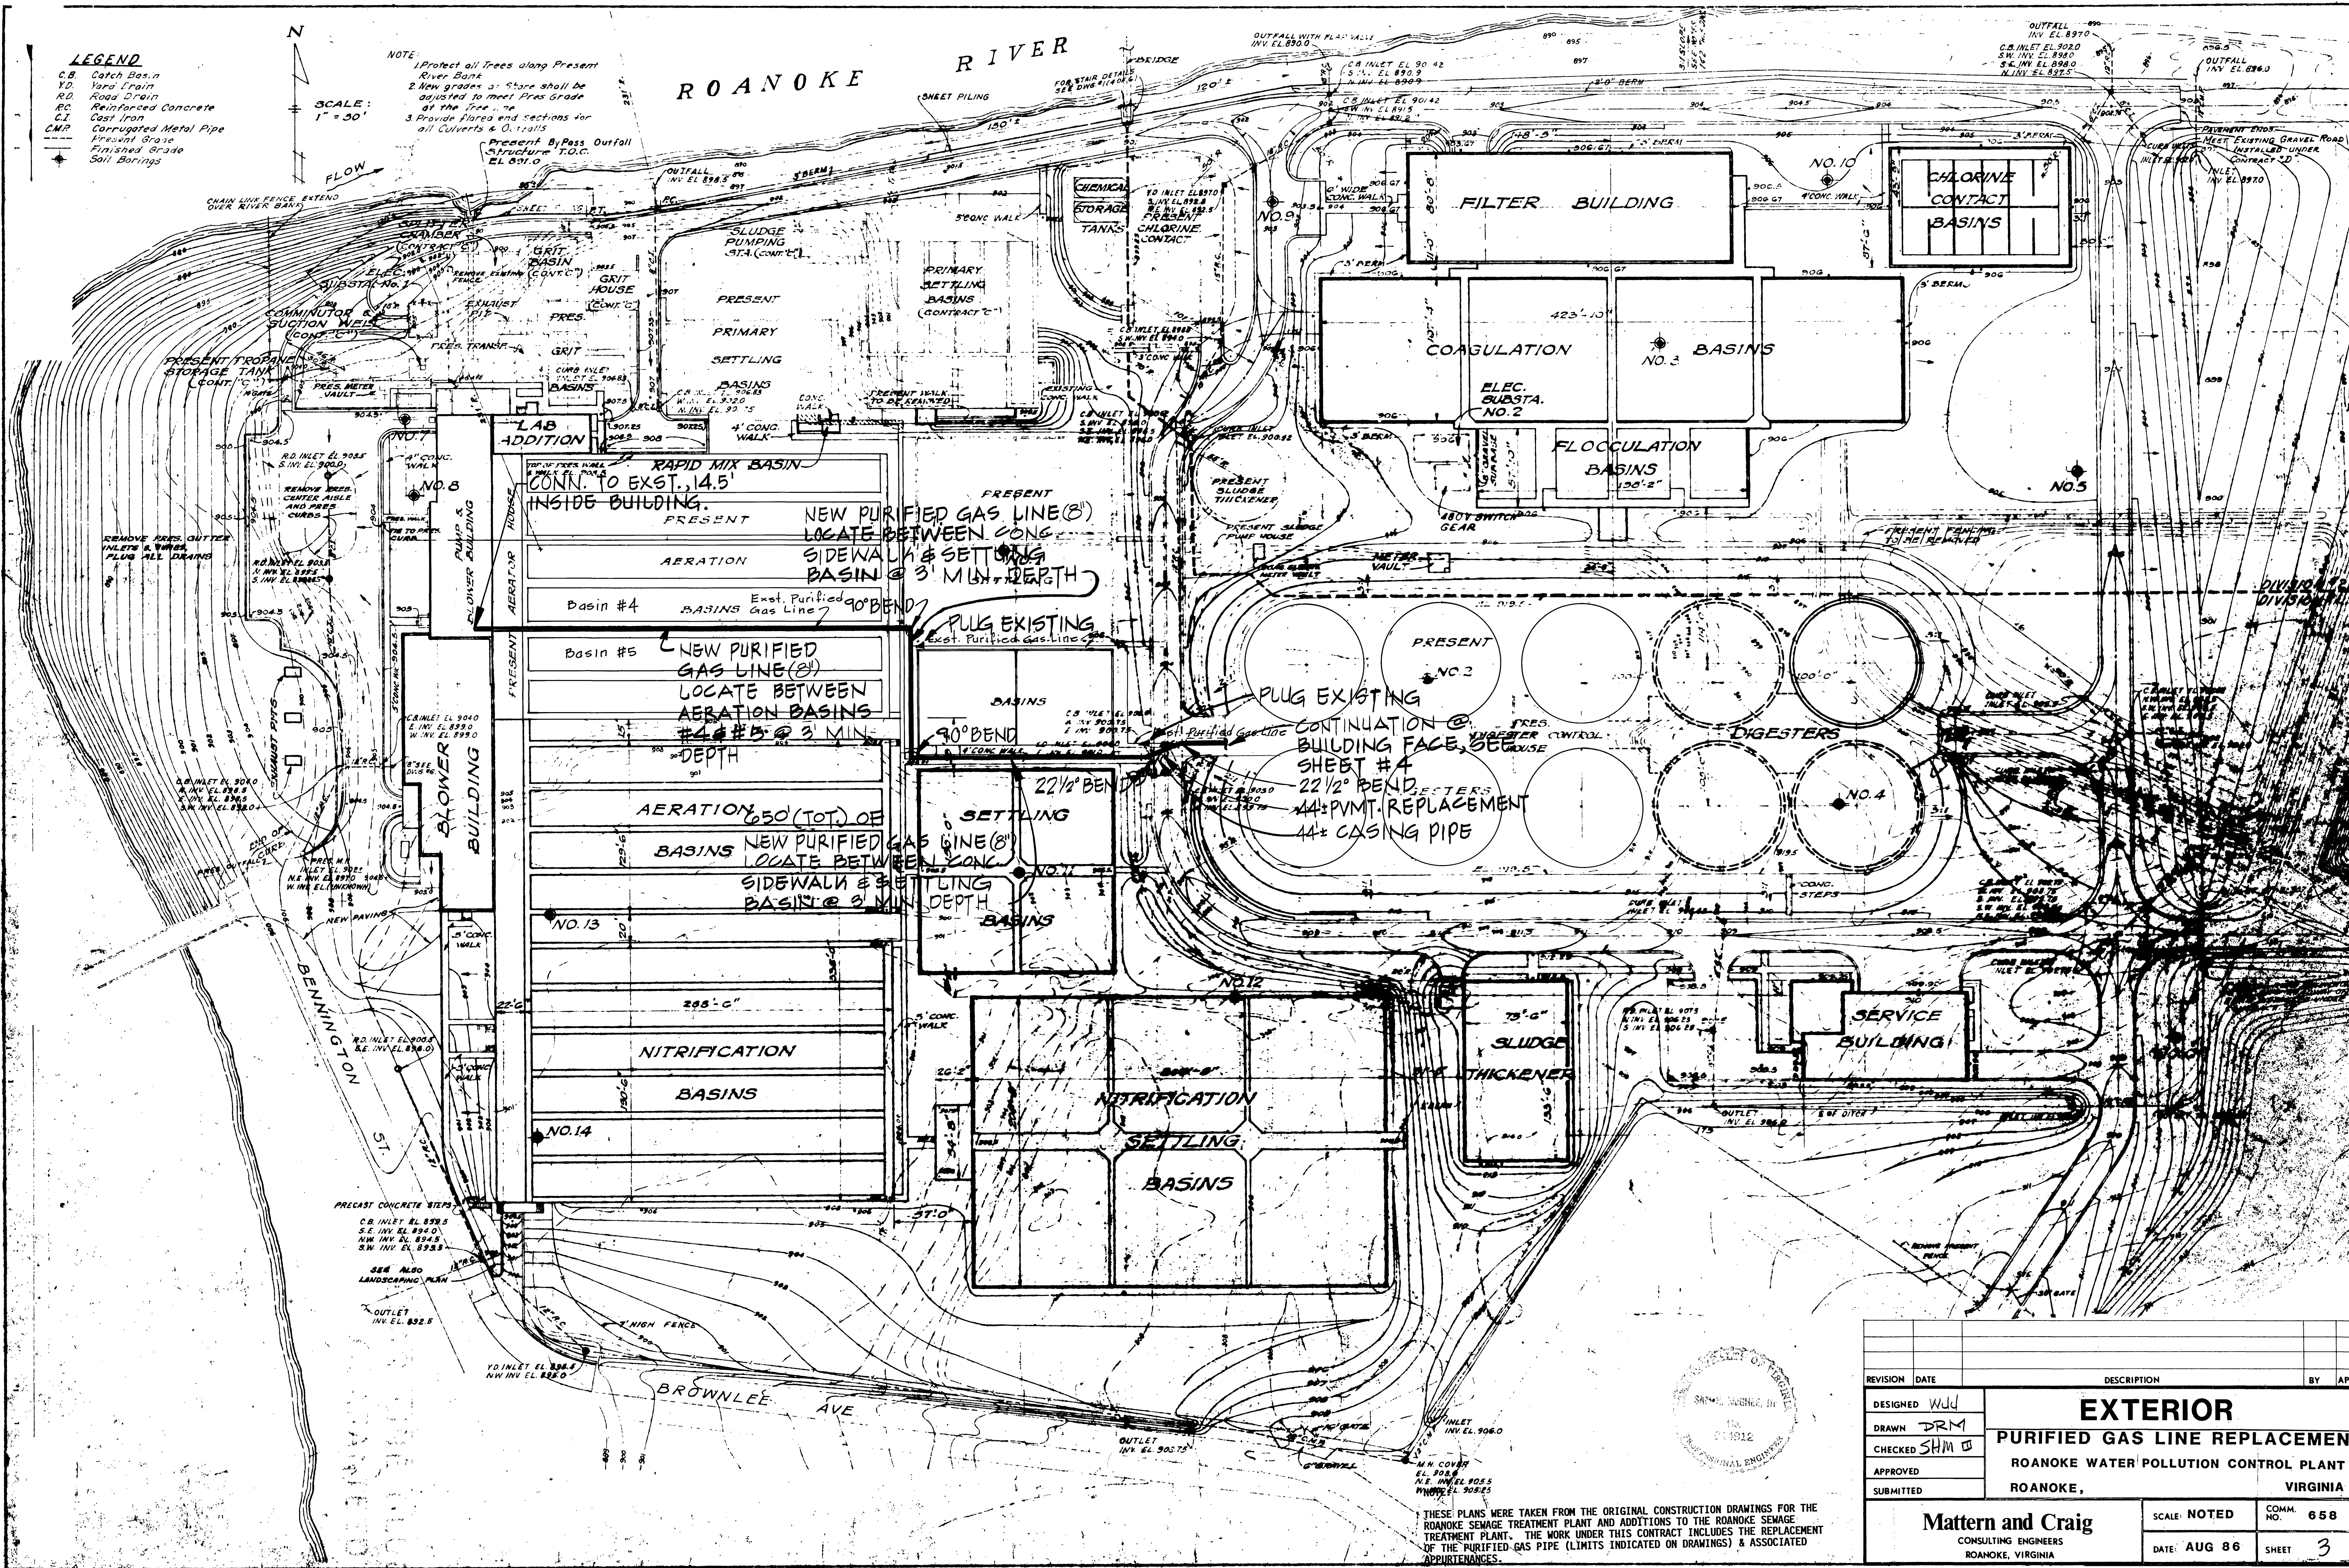

REVISION	DATE	DESCRIPTION	BY	APP
DESIGNED	WLD			
DRAWN	DRM			
CHECKED	SHM			
APPROVED				
SUBMITTED				

EXTERIOR	
PURIFIED GAS LINE REPLACEMENT	
ROANOKE WATER POLLUTION CONTROL PLANT	
ROANOKE,	VIRGINIA
Mattern and Craig	SCALE: NOTED
CONSULTING ENGINEERS	COMM. NO. 658
ROANOKE, VIRGINIA	DATE: AUG 86
	SHEET 3

THESE PLANS WERE TAKEN FROM THE ORIGINAL CONSTRUCTION DRAWINGS FOR THE ROANOKE SEWAGE TREATMENT PLANT AND ADDITIONS TO THE ROANOKE SEWAGE TREATMENT PLANT. THE WORK UNDER THIS CONTRACT INCLUDES THE REPLACEMENT OF THE PURIFIED GAS PIPE (LIMITS INDICATED ON DRAWINGS) & ASSOCIATED APPURTENANCES.