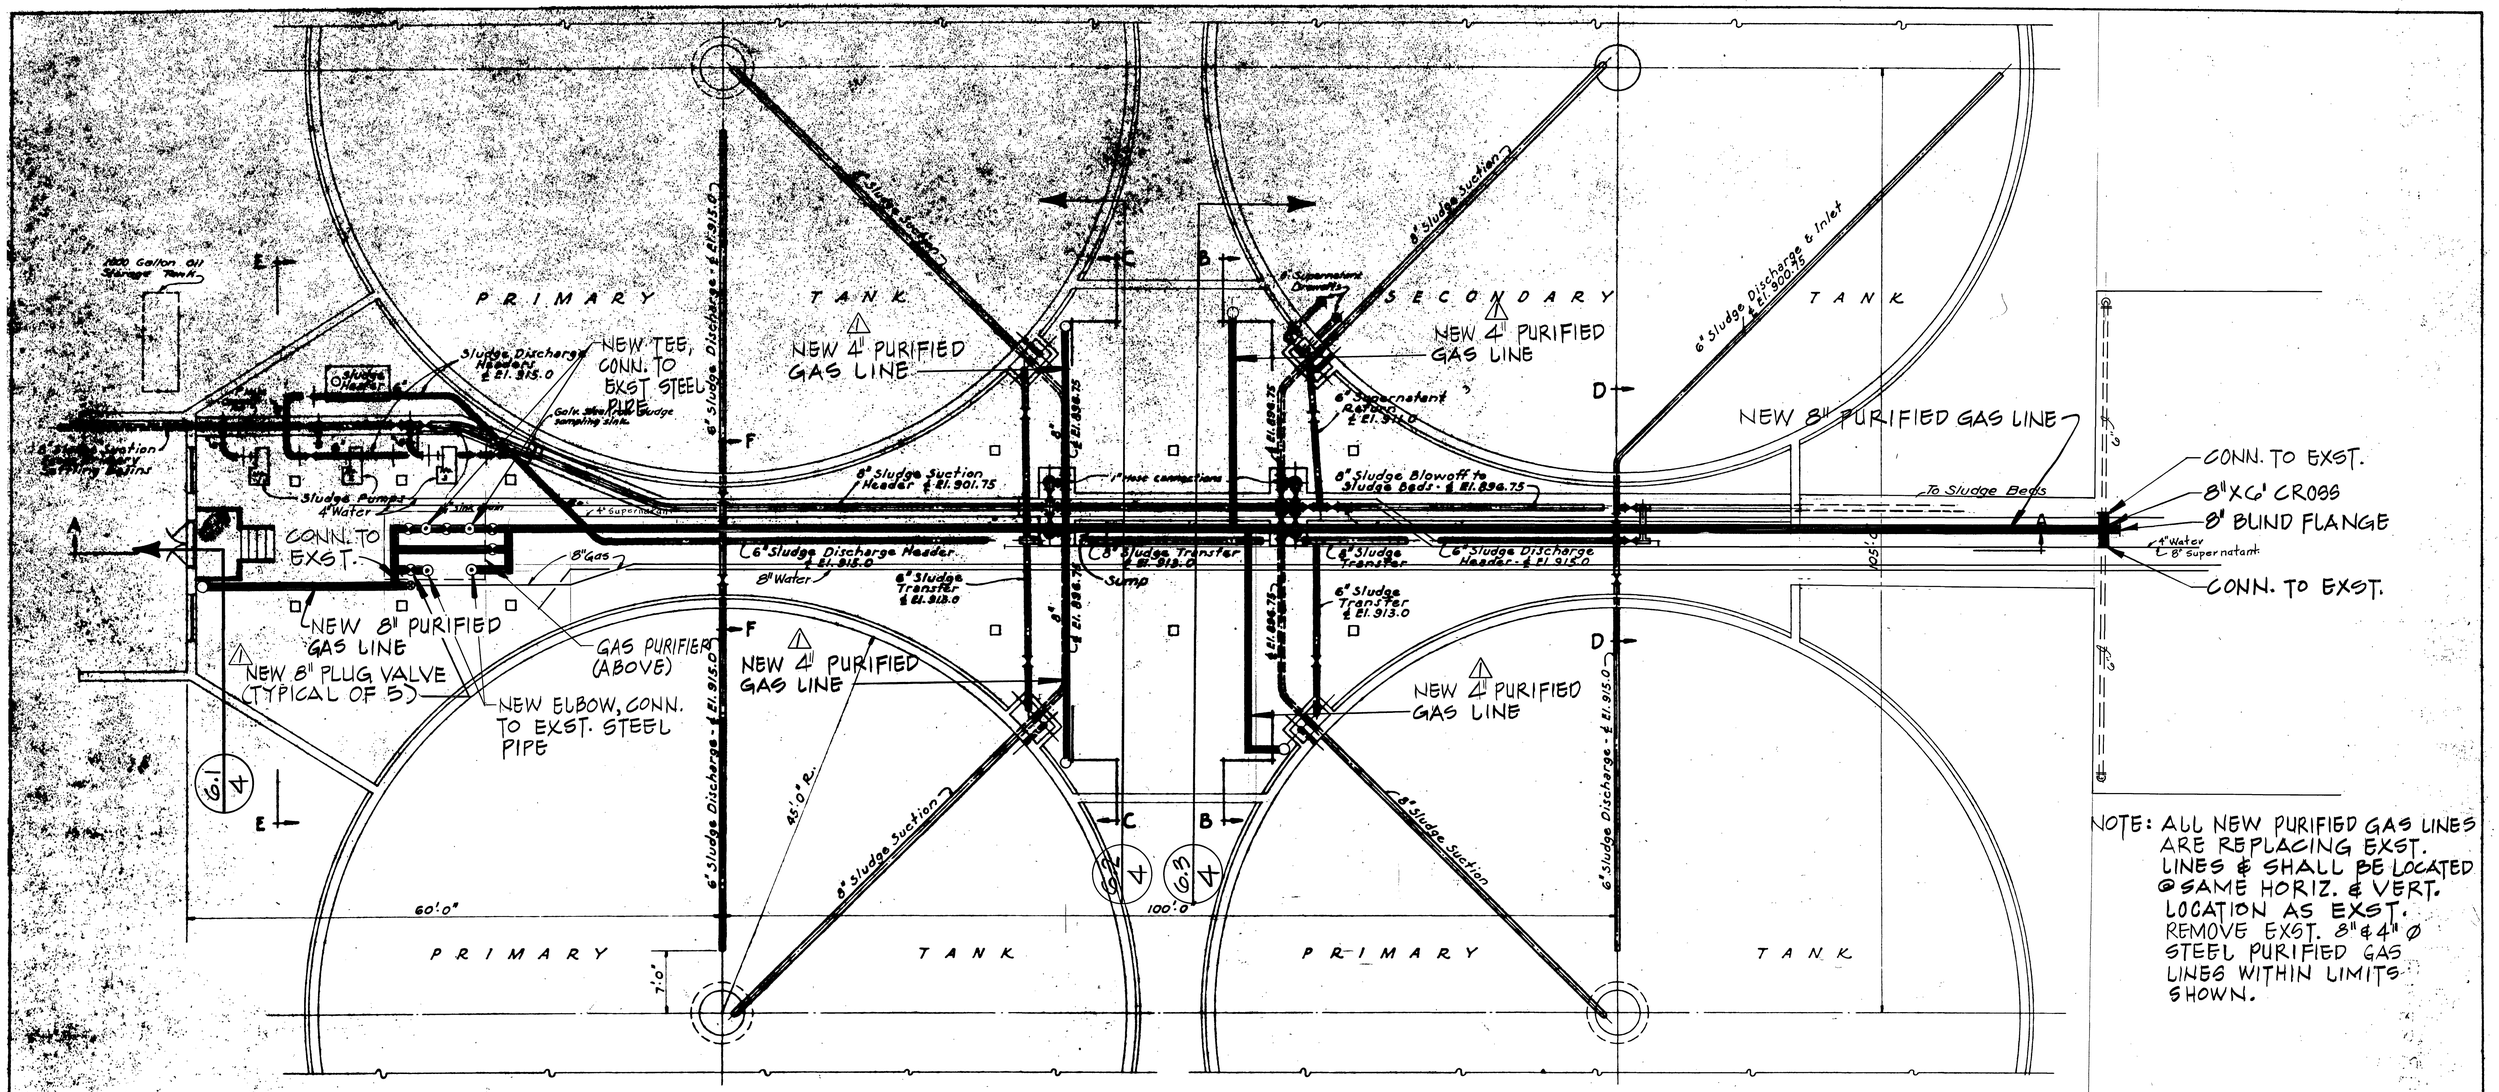

NOTE: ALL NEW PURIFIED GAS LINES ARE REPLACING EXST. LINES & SHALL BE LOCATED @ SAME HORIZ. & VERT. LOCATION AS EXST. REMOVE EXST. 8" & 4" Ø STEEL PURIFIED GAS LINES WITHIN LIMITS SHOWN.

PLAN OF DIGESTION TANK SLUDGE PIPING

SCALE: 1/8" = 1'-0"

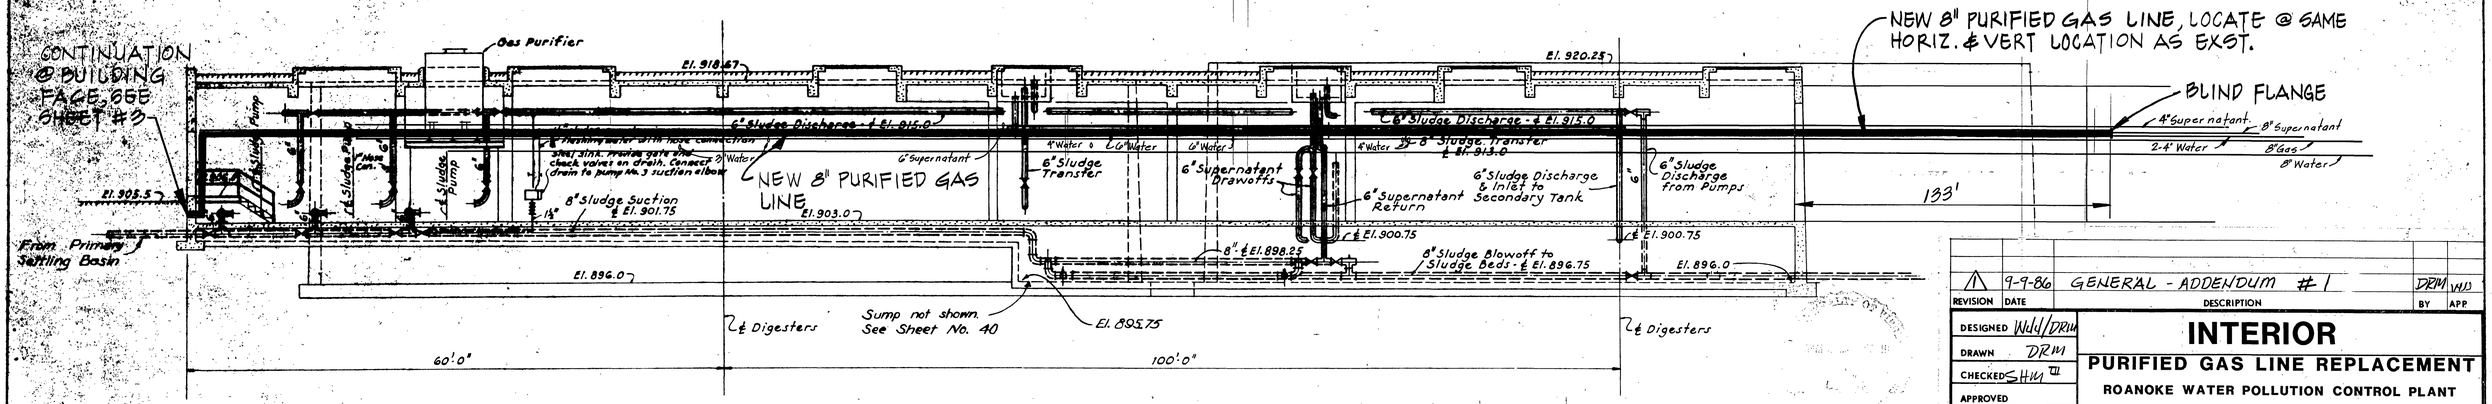

SECTION A-A

SCALE: 1/8" = 1'-0"

NOTE:
THESE PLANS WERE TAKEN FROM THE ORIGINAL CONSTRUCTION DRAWINGS FOR THE ROANOKE SEWAGE TREATMENT PLANT AND ADDITIONS TO THE ROANOKE SEWAGE TREATMENT PLANT. THE WORK UNDER THIS CONTRACT INCLUDES THE REPLACEMENT OF THE PURIFIED GAS PIPE (LIMITS INDICATED ON DRAWINGS) & ASSOCIATED APPURTENANCES.

REVISION	DATE	DESCRIPTION	BY	APP
1	9-9-86	GENERAL - ADDENDUM #1	DRM	WHJ

DESIGNED WHJ/DRM
DRAWN DRM
CHECKED SHM
APPROVED
SUBMITTED

INTERIOR

PURIFIED GAS LINE REPLACEMENT

ROANOKE WATER POLLUTION CONTROL PLANT

ROANOKE, VIRGINIA

Mattern and Craig
CONSULTING ENGINEERS
ROANOKE, VIRGINIA

SCALE: NOTED | COMM. NO. 658
DATE: AUG 86 | SHEET 4