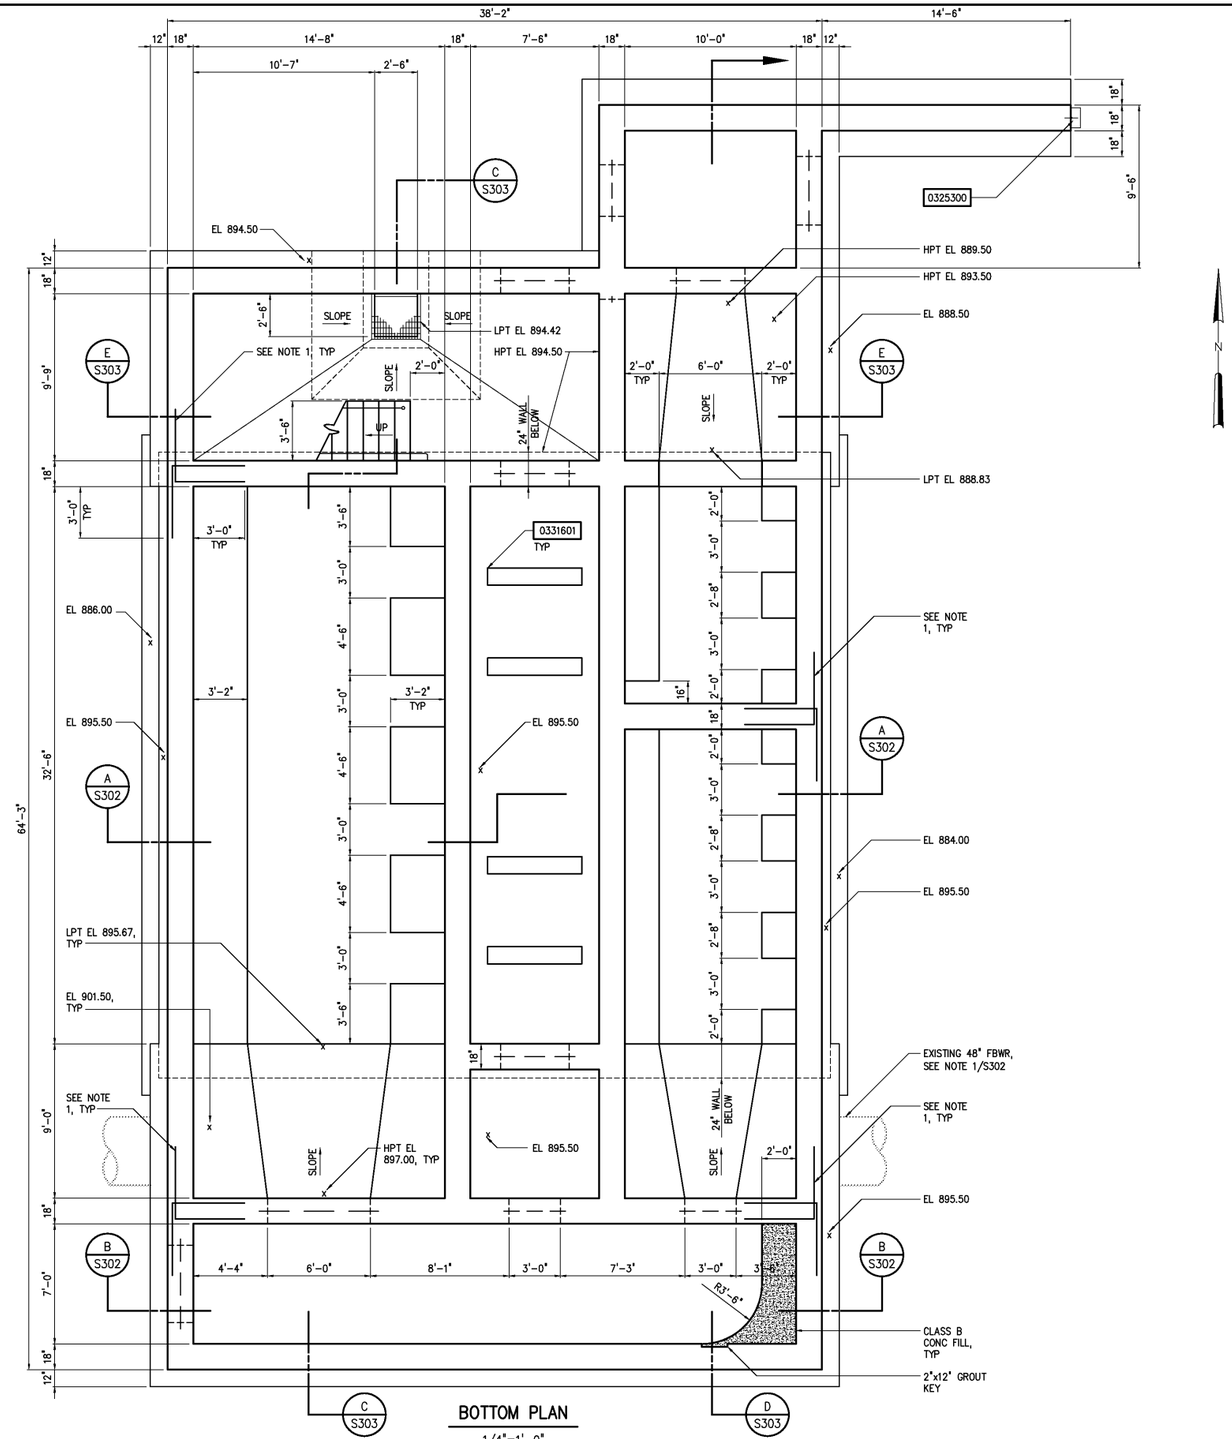

BOTTOM PLAN

1/4"=1'-0"

NOTES:

1 PROVIDE #6@8" ADDITIONAL HORIZONTAL BARS IN WALLS WHERE NOTED ON PLANS. ADDITIONAL BARS SHALL ALTERNATE WITH MAIN BARS SHOWN IN SECTIONS. ADDITIONAL BARS SHALL BE PROVIDED IN ADDITION TO TYPICAL WALL REINFORCING. ADDITIONAL BARS SHALL BE LOCATED BETWEEN ELEVATIONS 895.50 AND 909.50.

2 THE CONFIGURATION OF THE CONCRETE FILLETS IN THE WET WALLS, THE HORIZONTAL LOCATION OF WET WELL INFLUENT GATES, AND THE PUMP ACCESS HATCH LOCATIONS ARE REPRESENTATIVE OF ONE OF THE SPECIFIED PUMP MANUFACTURERS. ANY CHANGES REQUIRED TO ACCOMMODATE OTHER MANUFACTURERS WILL BE AT THE COST OF THE CONTRACTOR.

NO.	ISSUED FOR	DATE	BY
	RECORD DRAWINGS	MAR 2008	RLT
	CONSTRUCTION	MAR 2004	RLT
	REGULATORY APPROVAL	NOV 2003	RLT
	PRELIMINARY DESIGN	NOV 2002	RLT

DESIGNED WGL/AH
DRAWN AH
CHECKED
PROJ. ENGR. DAN
APPROVED

THIS DOCUMENT ORIGINALLY ISSUED FOR CONSTRUCTION AND SEALED BY ROBERT S. DIFIORE, SEAL NO. 22769

THIS DOCUMENT ORIGINALLY ISSUED FOR CONSTRUCTION AND SEALED BY RONALD L. TAYLOR, SEAL NO. 024649

RECORD DRAWING

THIS DRAWING HAS BEEN MODIFIED TO REFLECT FIELD CHANGES REPORTED BY THE CONTRACTOR OR ANOTHER PARTY, BUT NOT VERIFIED BY THE CERTIFYING ENGINEER. THIS DOCUMENT ORIGINALLY ISSUED AND SEALED BY CHRISTOPHER T. PHILLIPS, 033796. THIS MEDIA SHALL NOT BE CONSIDERED A CERTIFIED DOCUMENT.

HAZEN AND SAWYER
Environmental Engineers & Scientists
4011 WestChase Blvd, Raleigh, North Carolina 27607

CITY OF ROANOKE
VIRGINIA

REGIONAL WATER POLLUTION CONTROL PLANT
WET WEATHER IMPROVEMENTS

BAF/EQ PUMP STATION
STRUCTURAL
BOTTOM PLAN

THE SCALE BAR SHOWN BELOW MEASURES ONE INCH LONG ON THE ORIGINAL DRAWING.

DATE JULY 2003
H & S JOB NUMBER 30788A
CONTRACT NUMBER A
DRAWING NUMBER S300

PLOT DATE 07/08/03 12:08pm FILE= H:\30788\30788A\STRU\s300 by DZIMPEL XREFs=30788s\misc\30786tb, 300\vps-pb,