



NOTES:

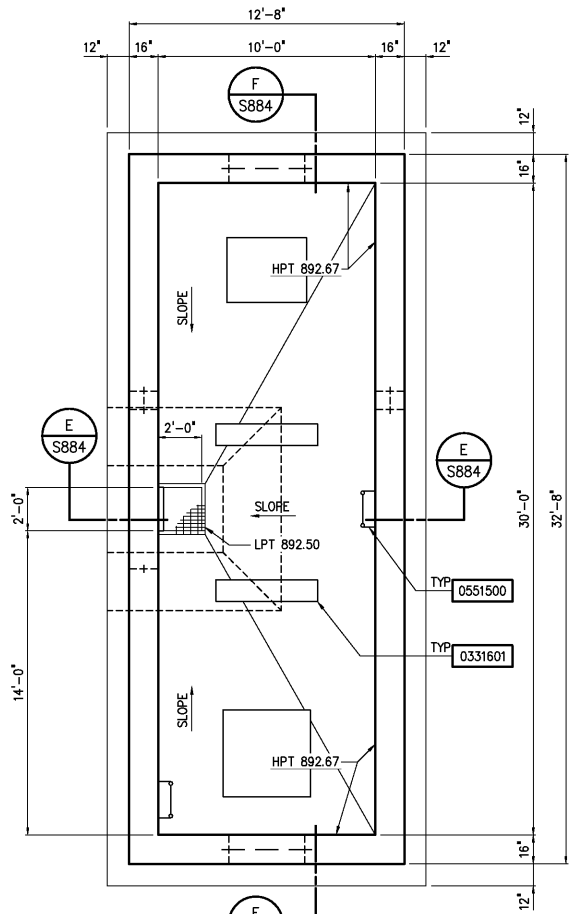


PE/WAS FLOW CONTROL VALVE AND  
METER VAULT - BOTTOM PLAN

1/4"=1'-0"

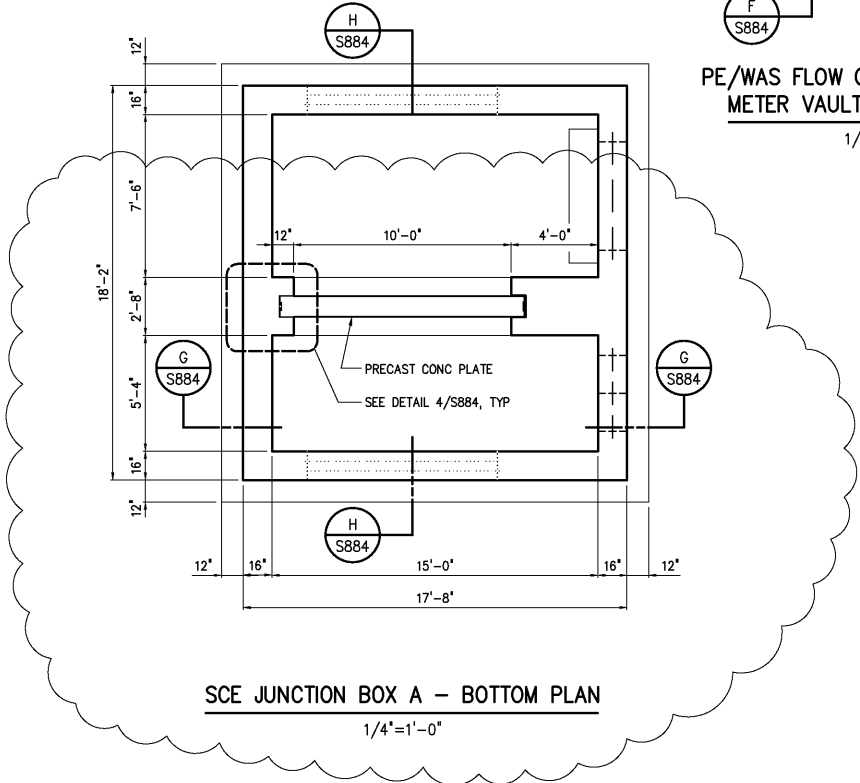


SCE JUNCTION BOX A - BOTTOM PLAN

1/4"=1'-0"

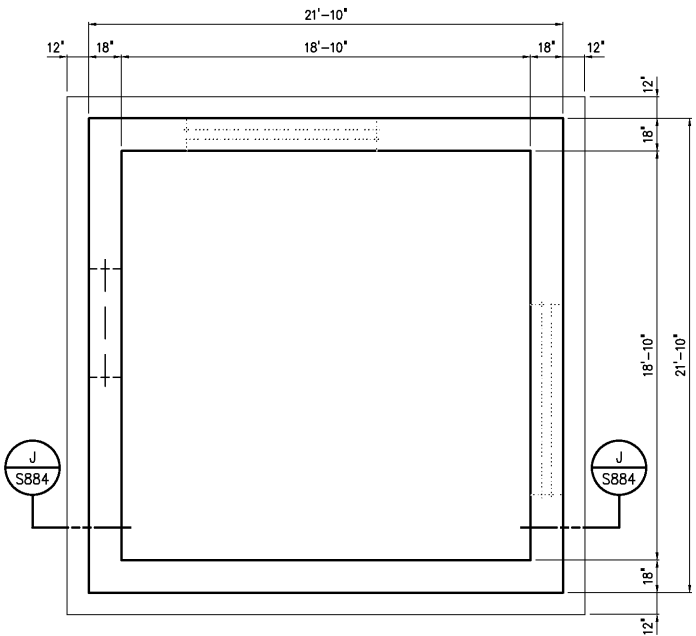

SCE JUNCTION BOX C - BOTTOM PLAN

1/4"=1'-0"

 

--	--	