



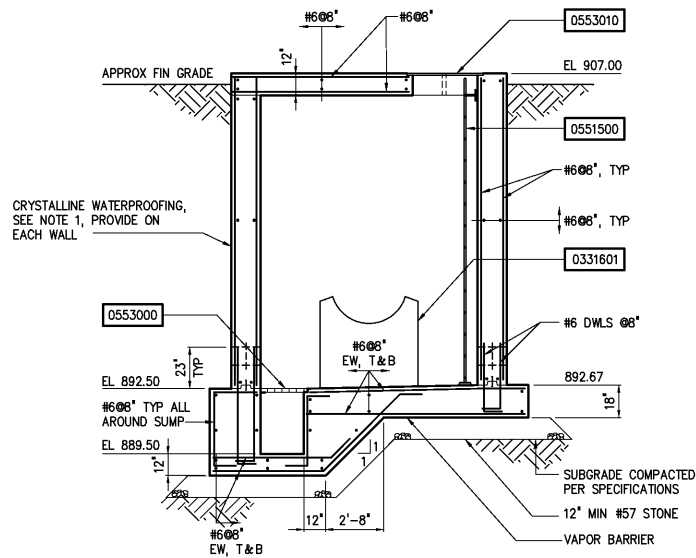


PE/WAS FLOW CONTROL VALVE
AND METER VAULT

SECTION **E**
1/4"=1'-0" S882

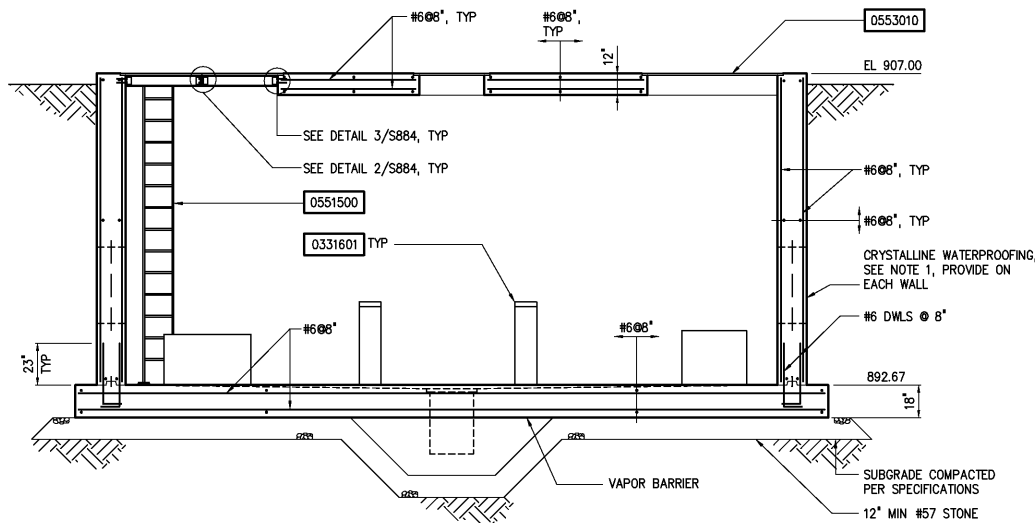


PE/WAS FLOW CONTROL VALVE
AND METER VAULT


SECTION **F**
1/4"=1'-0" S882

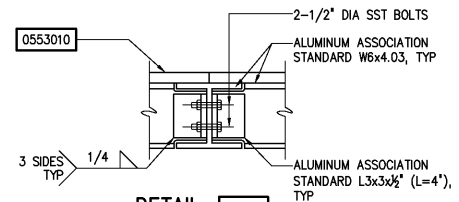

DETAIL **2**
1-1/2"=1'-0" S884

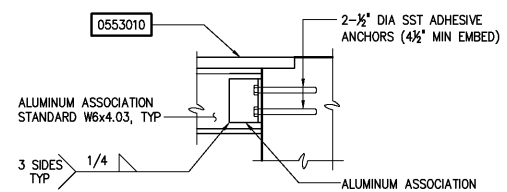


DETAIL **3**
1-1/2"=1'-0" S884

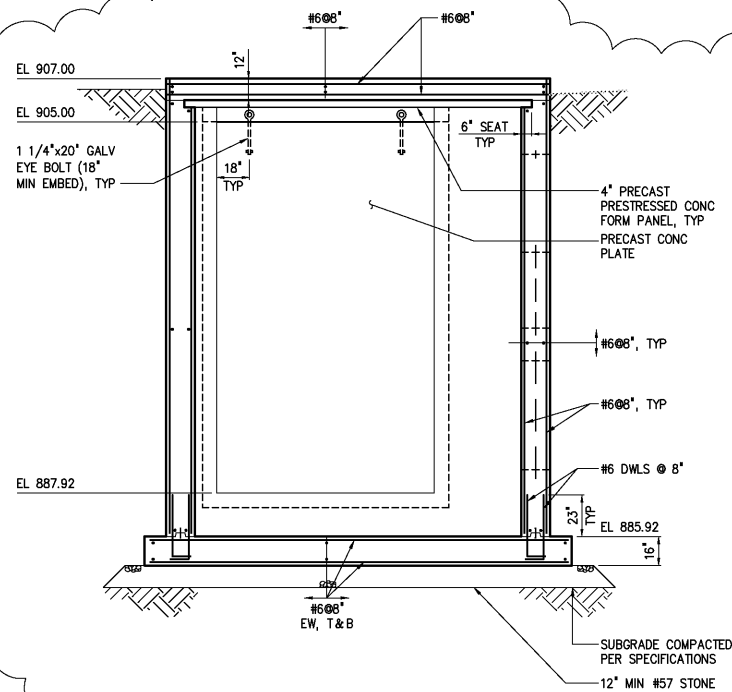


SCE JUNCTION BOX A

SECTION **G**
1/4"=1'-0" S882

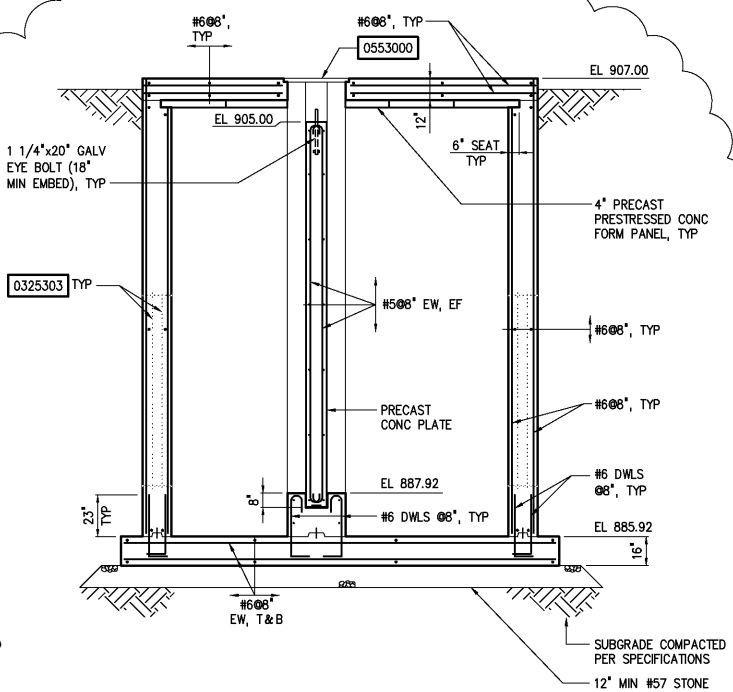


SCE JUNCTION BOX A

SECTION **H**
1/4"=1'-0" S882

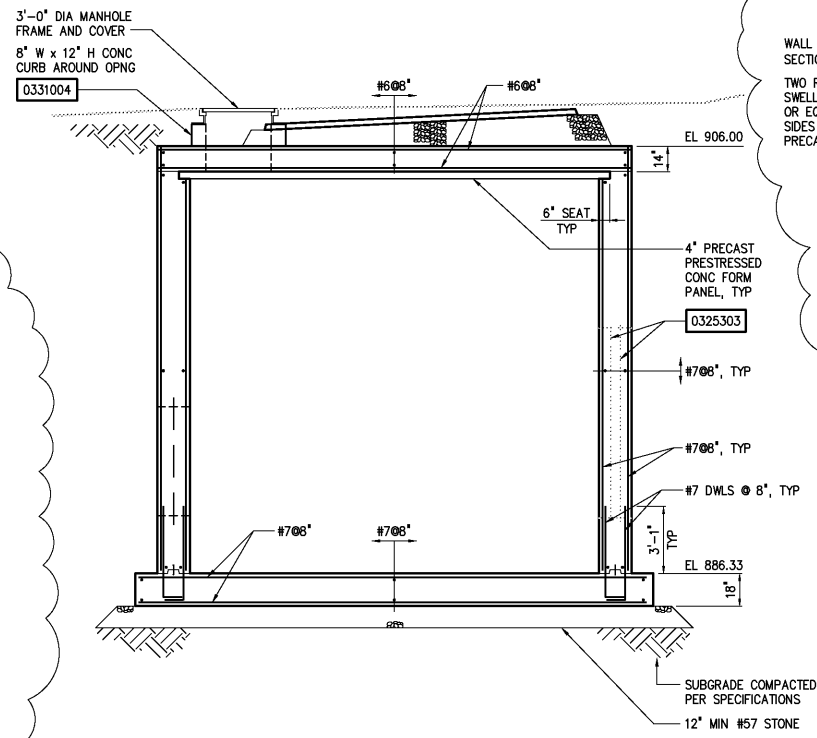

SCE JUNCTION BOX C

SECTION **J**
1/4"=1'-0" S882

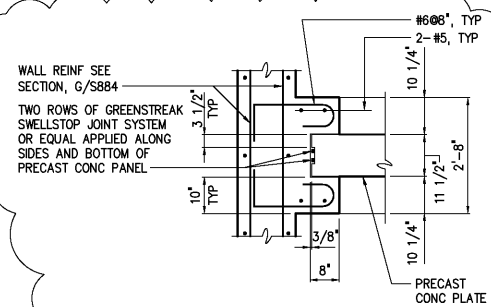

DETAIL **4**
1/2"=1'-0" S882

NOTE: AFTER CONCRETE PLATE IS INSTALLED, CONTRACTOR SHALL INSTALL SHIMS ALONG SIDES AND BOTTOM TO PREVENT MOVEMENT OF THE PLATE. SHIMS SHALL BE KORALATH PLASTIC OR EQUAL.

NOTES:

1 CRYSTALLINE WATERPROOFING SHALL BE PROVIDED ON THE EXTERIOR FACE OF ALL WALLS THAT ACT AS A BARRIER BETWEEN DRY INHABITED SPACES AND BACKFILL. SEE SPECIFICATION SECTION 07100.

--	--	