NOTES:

1. EQUIP BREAKERS WITH THE FOLLOWING PLUGS:
   a. MCC-10 FEEDER: 1000 AMP PLUG
   b. MCC-11 FEEDER: 1000 AMP PLUG
   c. MCC-12 FEEDER: 800 AMP PLUG
   d. MAIN BREAKER: 3200 AMP PLUG
   e. SPARE BREAKERS: 800 AMP PLUG
2. CONTRACTOR SHALL PROVIDE WIRING FROM ELECTRIC METER TO METERING CABINET AS DIRECTED BY AEP.

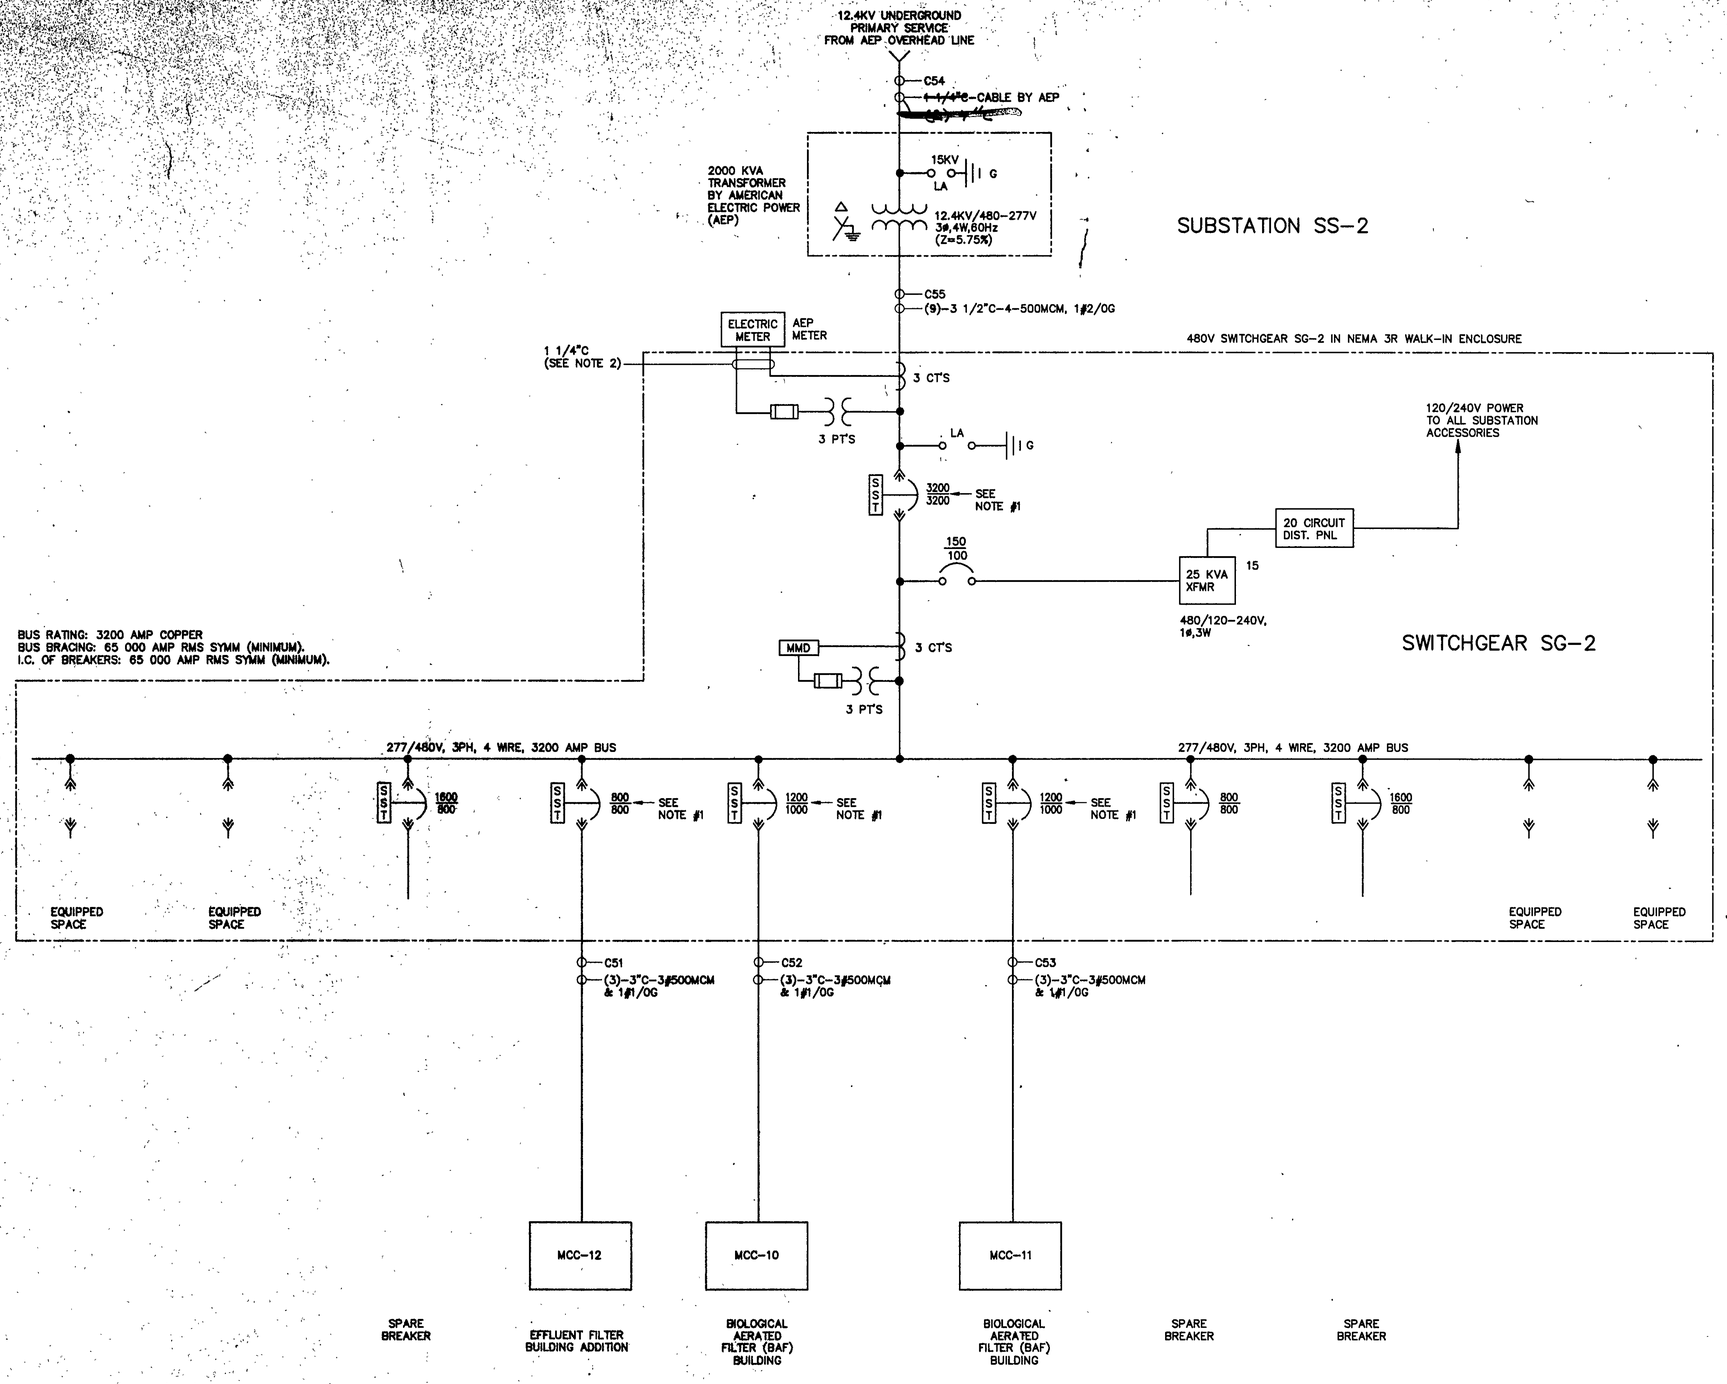

480V SUBSTATION SS-2 ONE LINE DIAGRAM

RECORD DRAWINGS

MALCOLM PIRNIE

REVISIONS			
NO.	BY	DATE	REMARKS

DES GJM/TK
DWN GJM/TK
CKD TK

CITY OF ROANOKE, VIRGINIA
WATER POLLUTION CONTROL PLANT UPGRADE AND EXPANSION

ELECTRICAL
SUBSTATION SS-2
ONE LINE DIAGRAM
SCALE: NONE

COPYRIGHT © 1997 MALCOLM PIRNIE, INC.

DATE MAY 1997
E SHEET 6 OF
CAD REF. NO. D0900