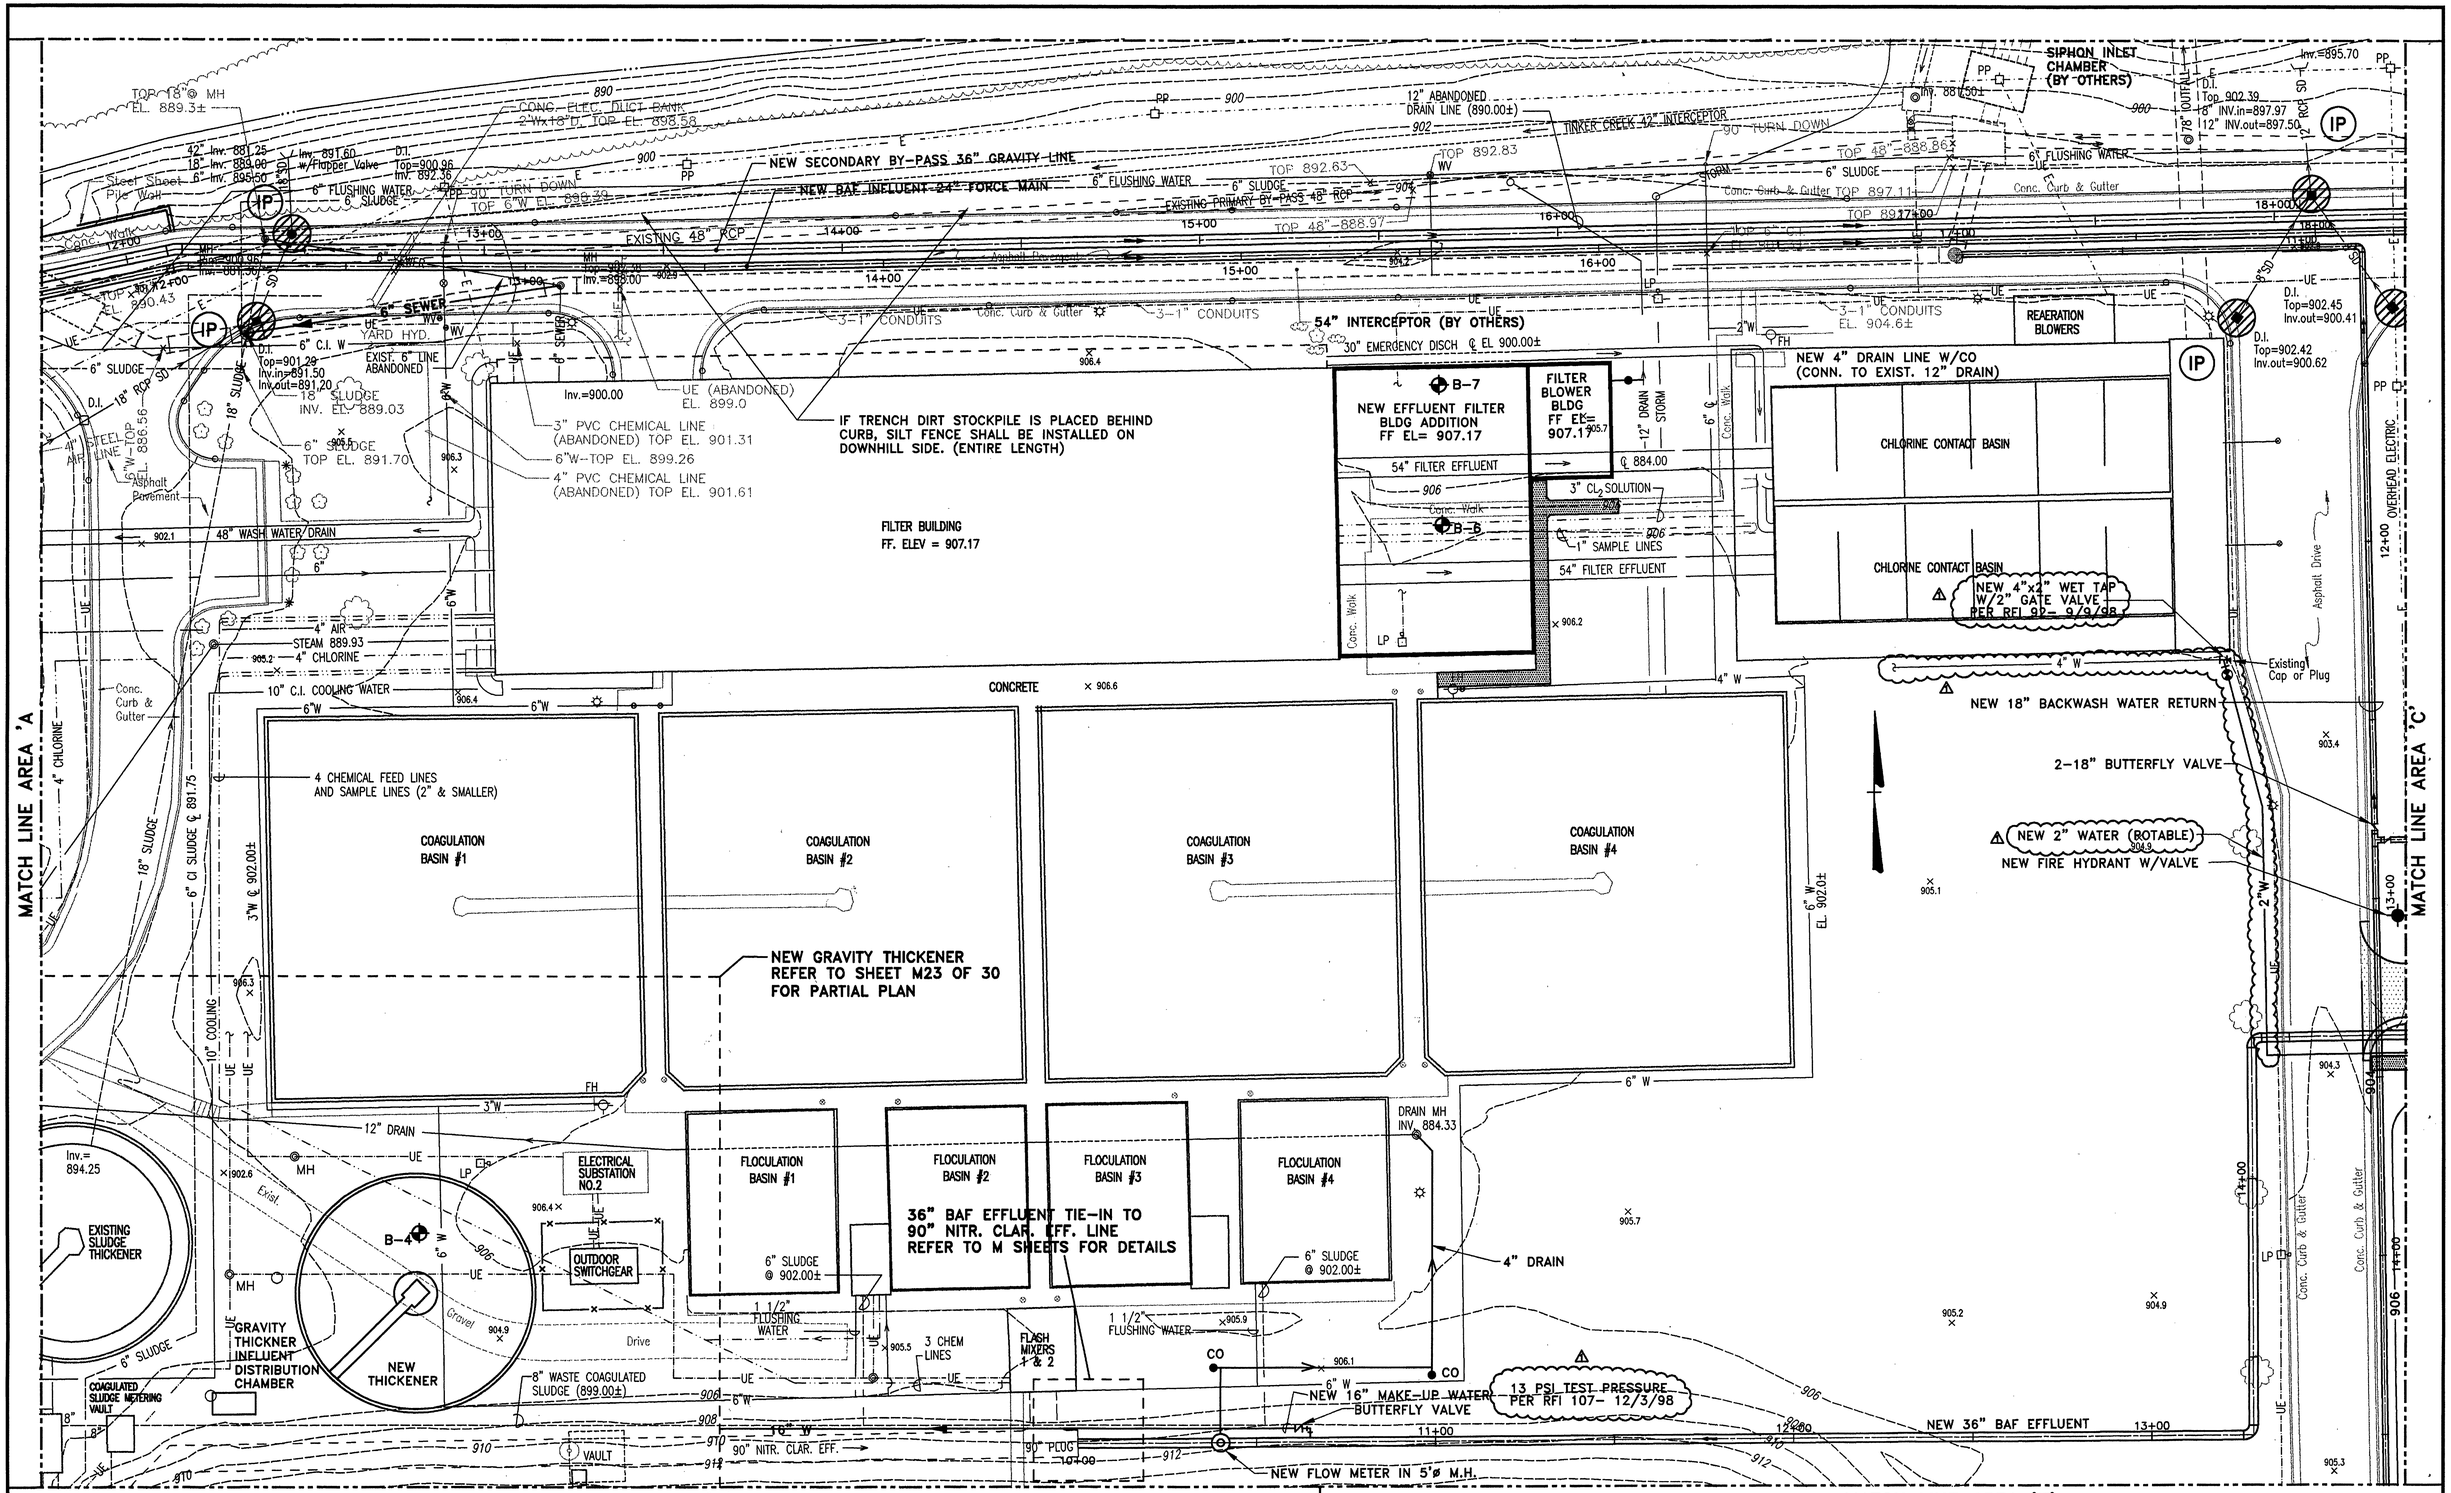

STEWART W. HUBBELL
NO. 07420
COMMONWEALTH OF VIRGINIA
PROFESSIONAL ENGINEER

Mattern & Craig, Inc.
CONSULTING ENGINEERS • SURVEYORS
701 FIRST STREET, S.W.
ROANOKE, VIRGINIA 24016
(540) 342-5643
(540) 342-7001 FAX

REVISIONS

NO.	BY	DATE	REMARKS
1	ARB	JAN. 2000	RECORD DRAWING

DES WTA
DWN LDL,ARB
CKD SWH

ROANOKE
VIRGINIA, CHARTERED 1882

CITY OF ROANOKE, VIRGINIA
WATER POLLUTION CONTROL PLANT UPGRADE AND EXPANSION

SITE PLAN
GRADING, STORM DRAINAGE, AND E&SC AREA 'B'
1"=20'

DATE MAY, 1997
G SHEET 11 OF 23
CAD REF. NO. G11.DWG