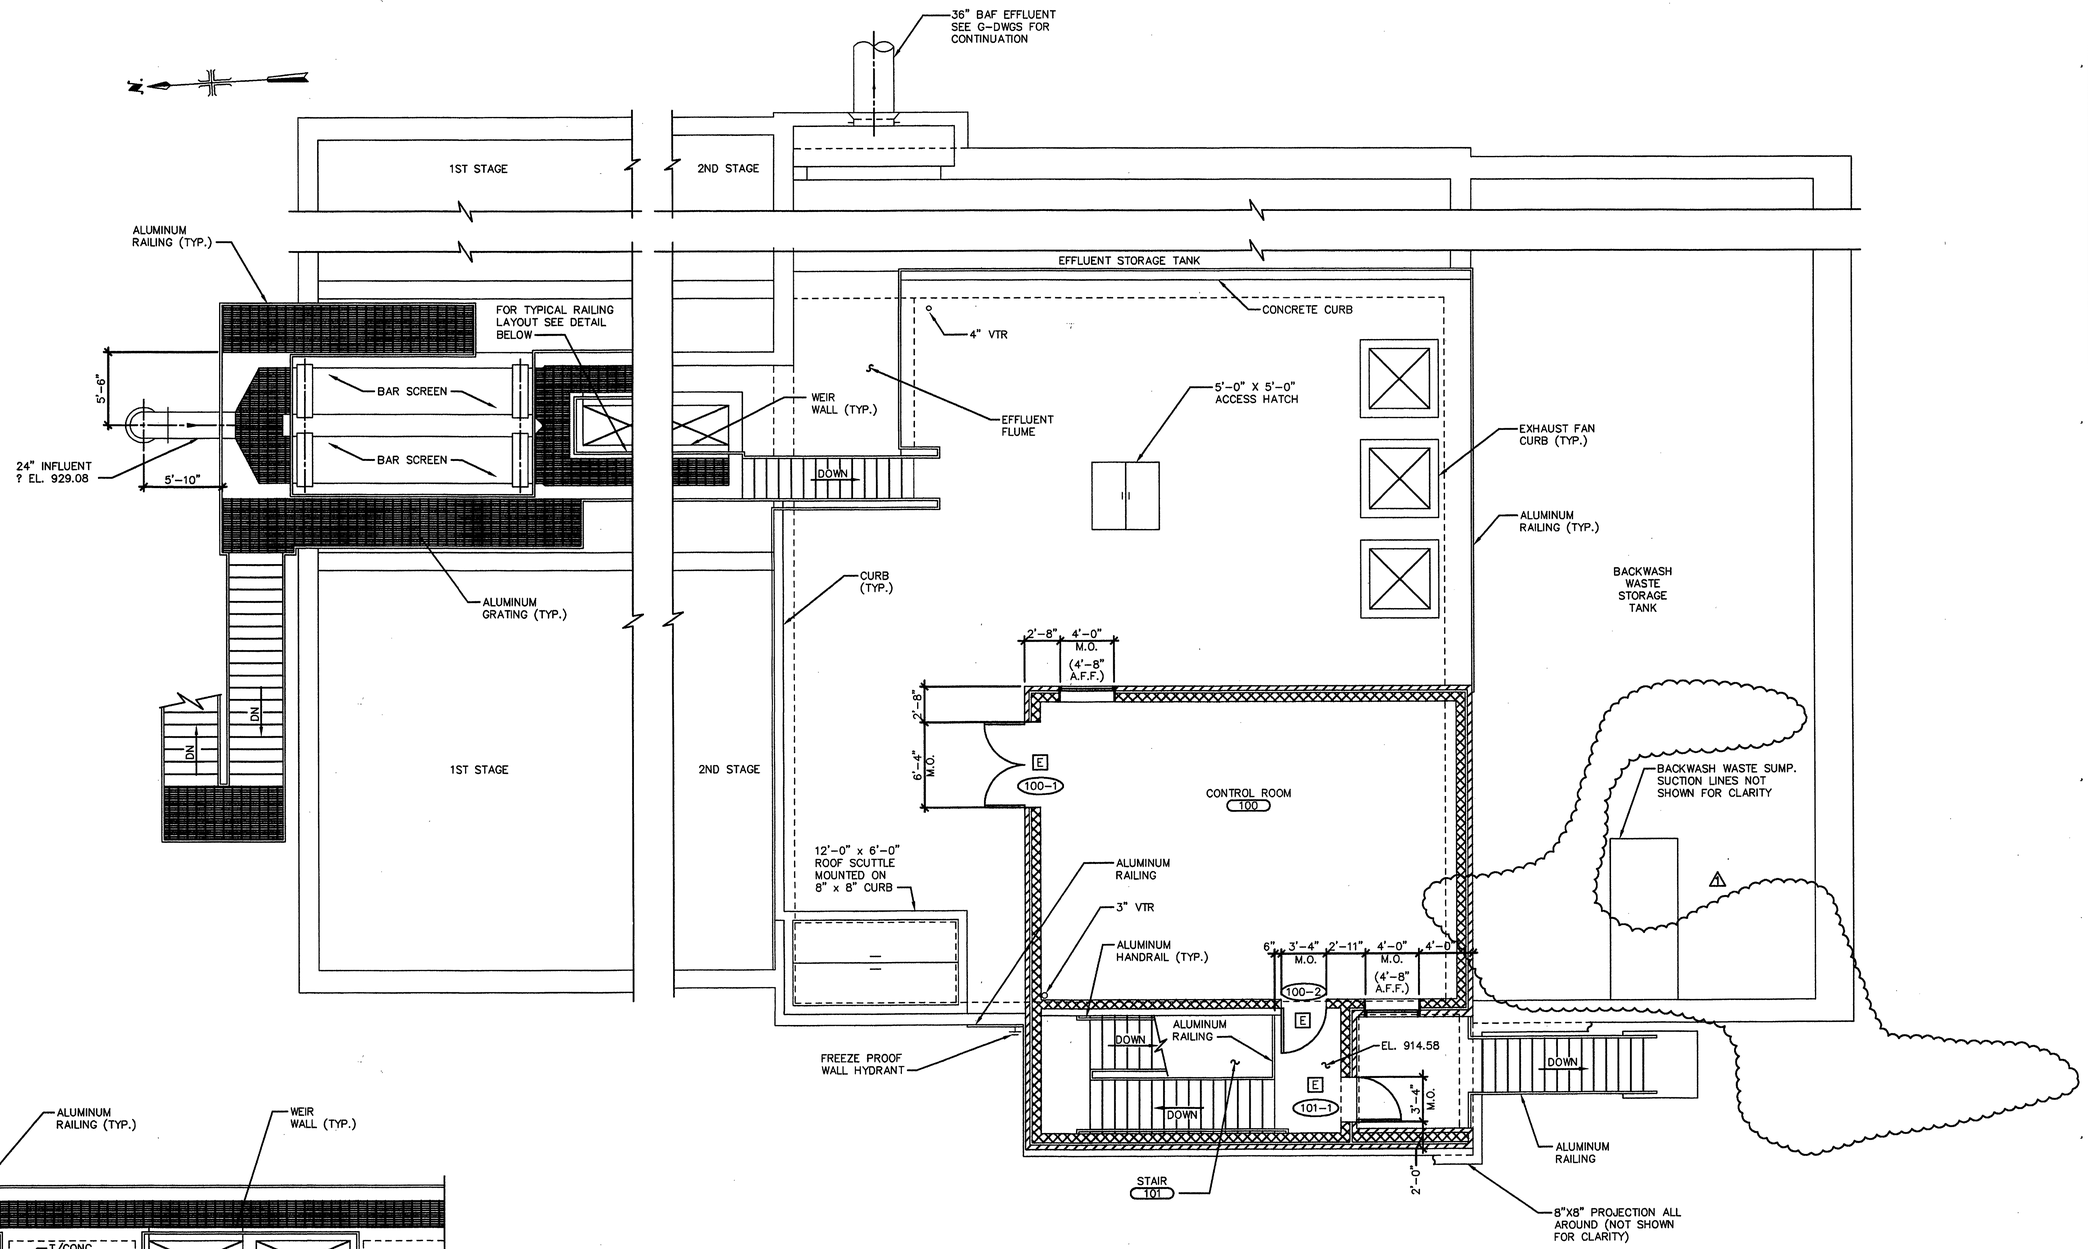

UPPER LEVEL PARTIAL PLAN

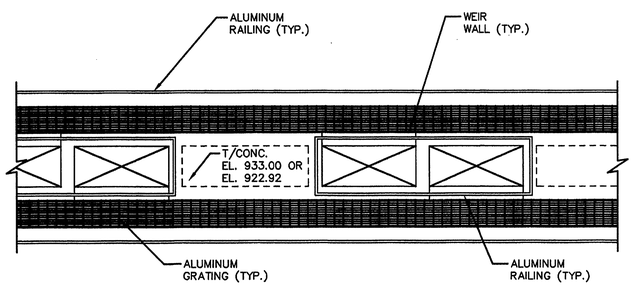

TYPICAL RAILING LAYOUT DETAIL

GENERAL NOTE:

NOT ALL BAF EQUIPMENT, PIPING, VALVES AND APPURTENANCES ARE SHOWN. SEE SPECIFICATIONS AND BAF MANUFACTURER'S SHOP DRAWINGS FOR ADDITIONAL ITEMS AND SCOPE OF EQUIPMENT, PIPING, VALVES AND APPURTENANCES SUPPLIED TO THE CONTRACTOR BY THE BAF MANUFACTURER.

MALCOLM PIRNIE
11832 Rock Landing Drive, Suite 400
Newport News, Virginia 23606

REVISIONS

NO.	BY	DATE	REMARKS
1	ARB	JAN. 2000	RECORD DRAWING

DES CWM/KML
DWN CWM/WEC
CKD GJJ

ROANOKE VIRGINIA, CHARTERED 1882

CITY OF ROANOKE, VIRGINIA
WATER POLLUTION CONTROL PLANT UPGRADE AND EXPANSION

BIOLOGICAL AERATED FILTER
UPPER LEVEL PARTIAL PLAN AND DETAIL
SCALE: 3/16" = 1'-0"

COPYRIGHT © 1997 MALCOLM PIRNIE, INC.

DATE MAY 1997
M SHEET 2 OF 26
CAD REF. NO. 0060M002

3919 : 0060028000\V:\ACAD\PROJ\0060028\MECH\0060M002 SCALE: 1:64 05/01, 1997 at 11:01