




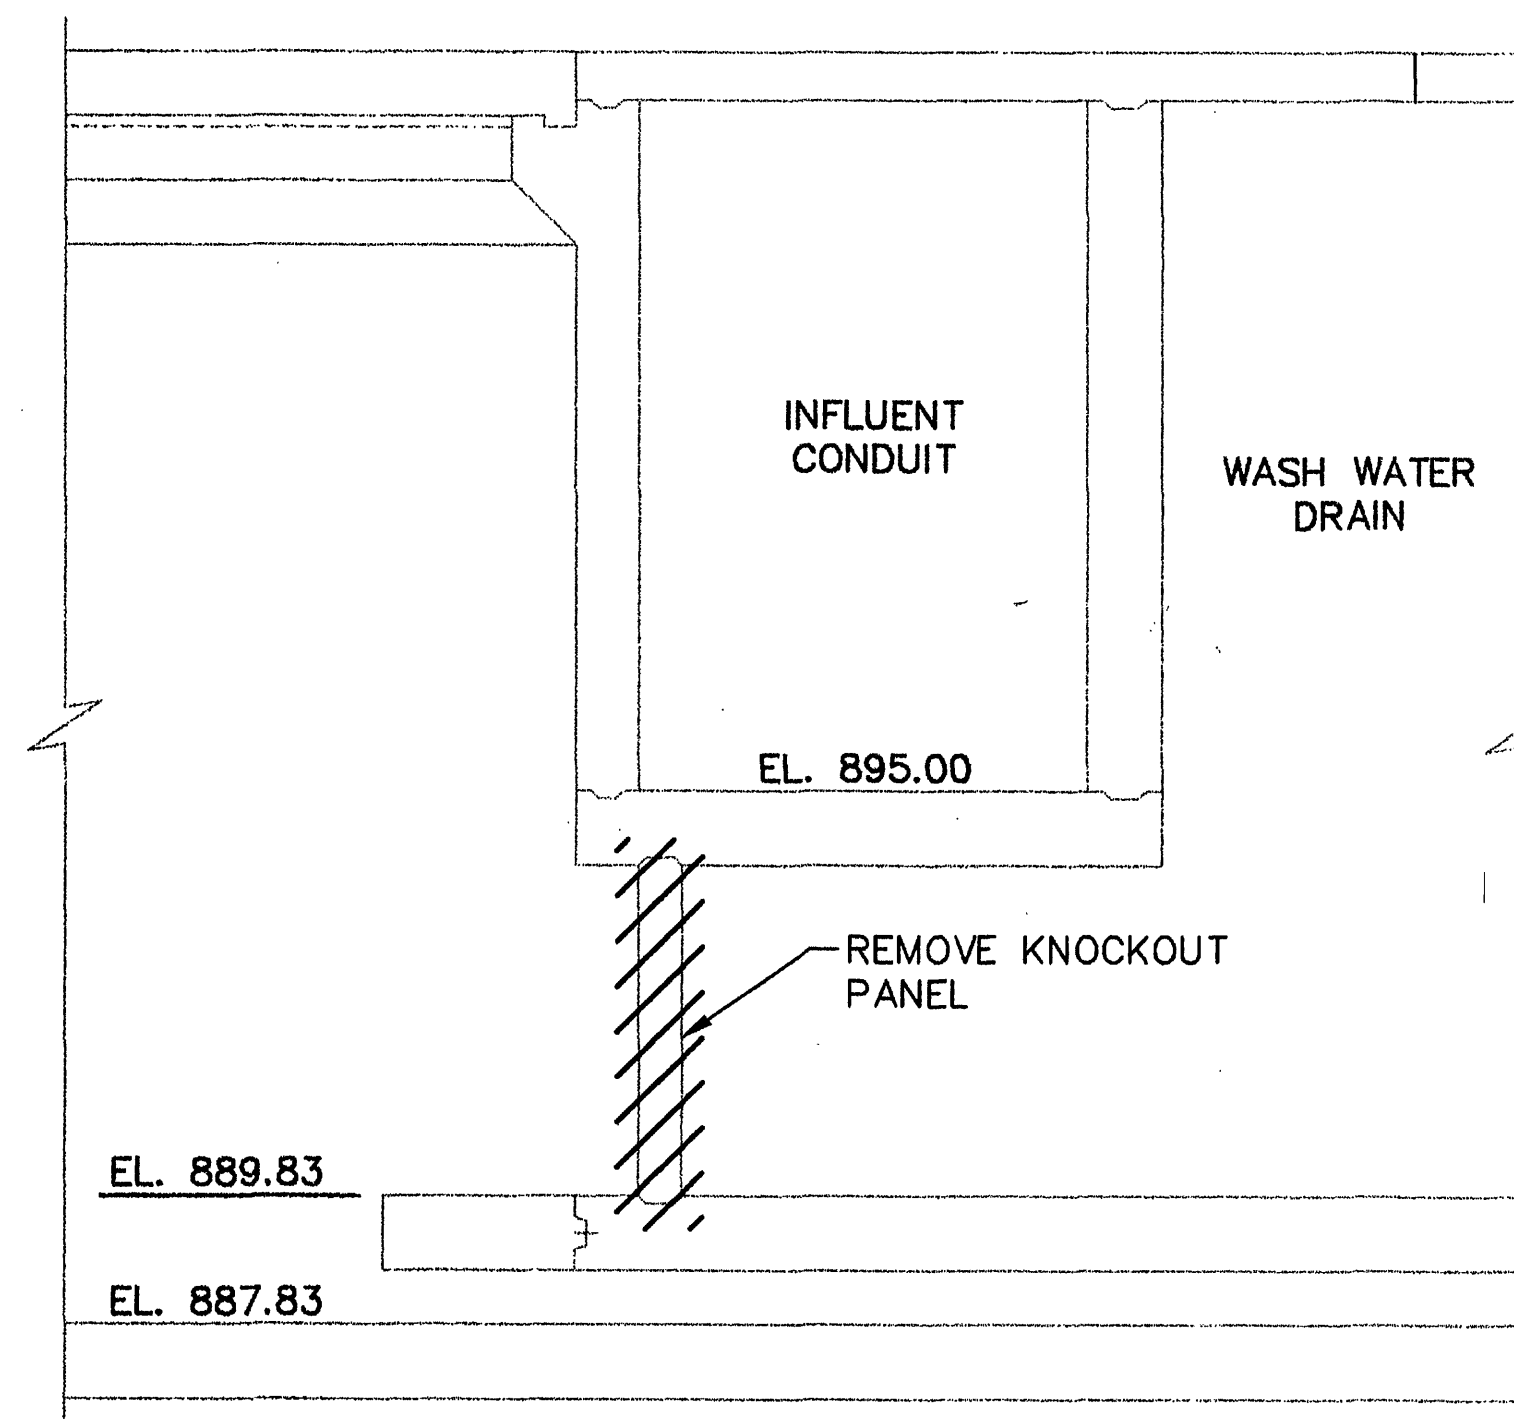

SECTION 2
SCALE: 1/4" = 1'-0"

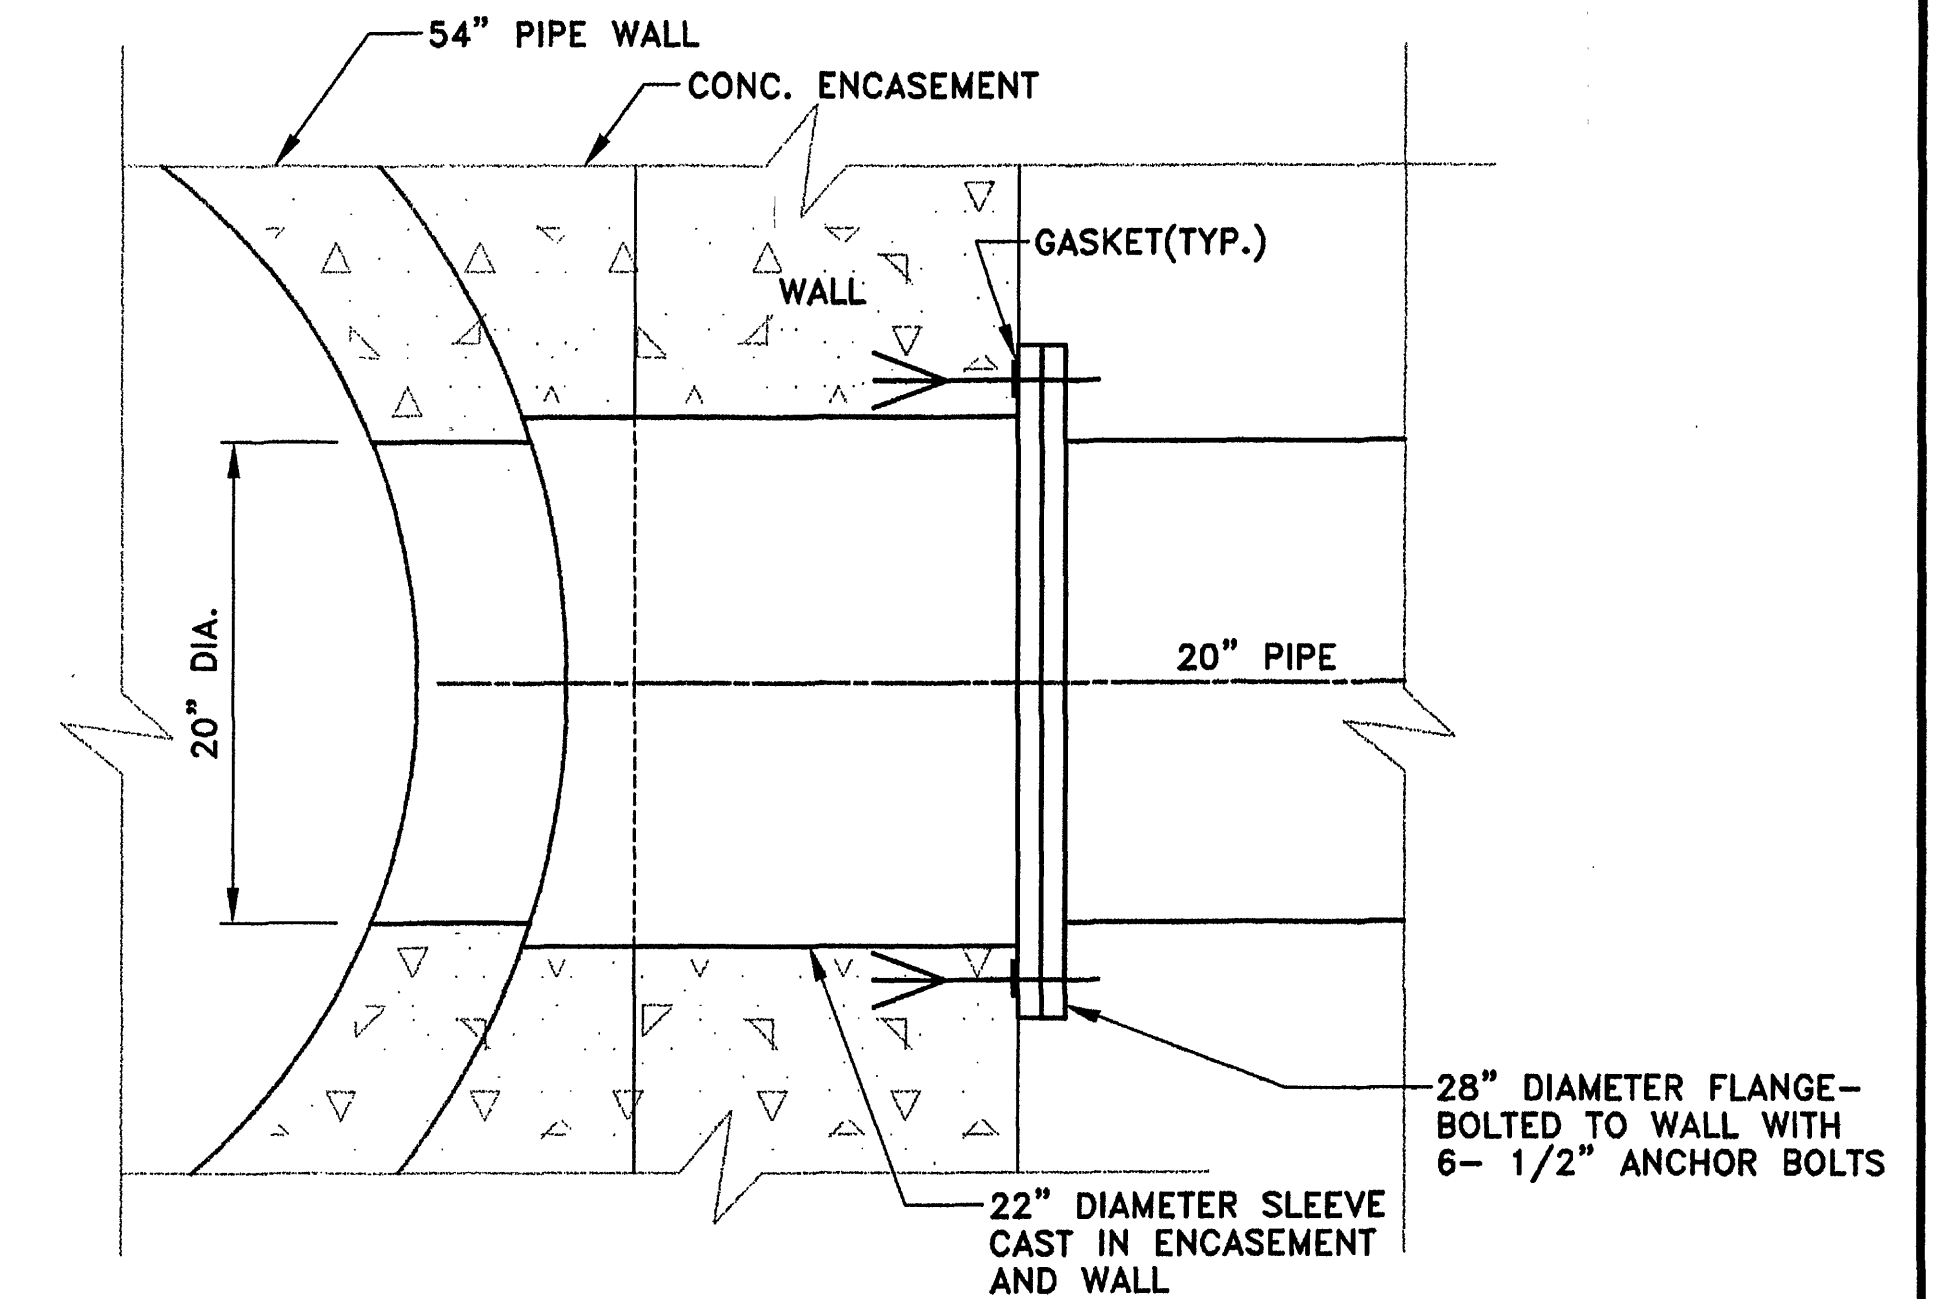

DETAIL
SCALE: 1-1/2" = 1'-0"

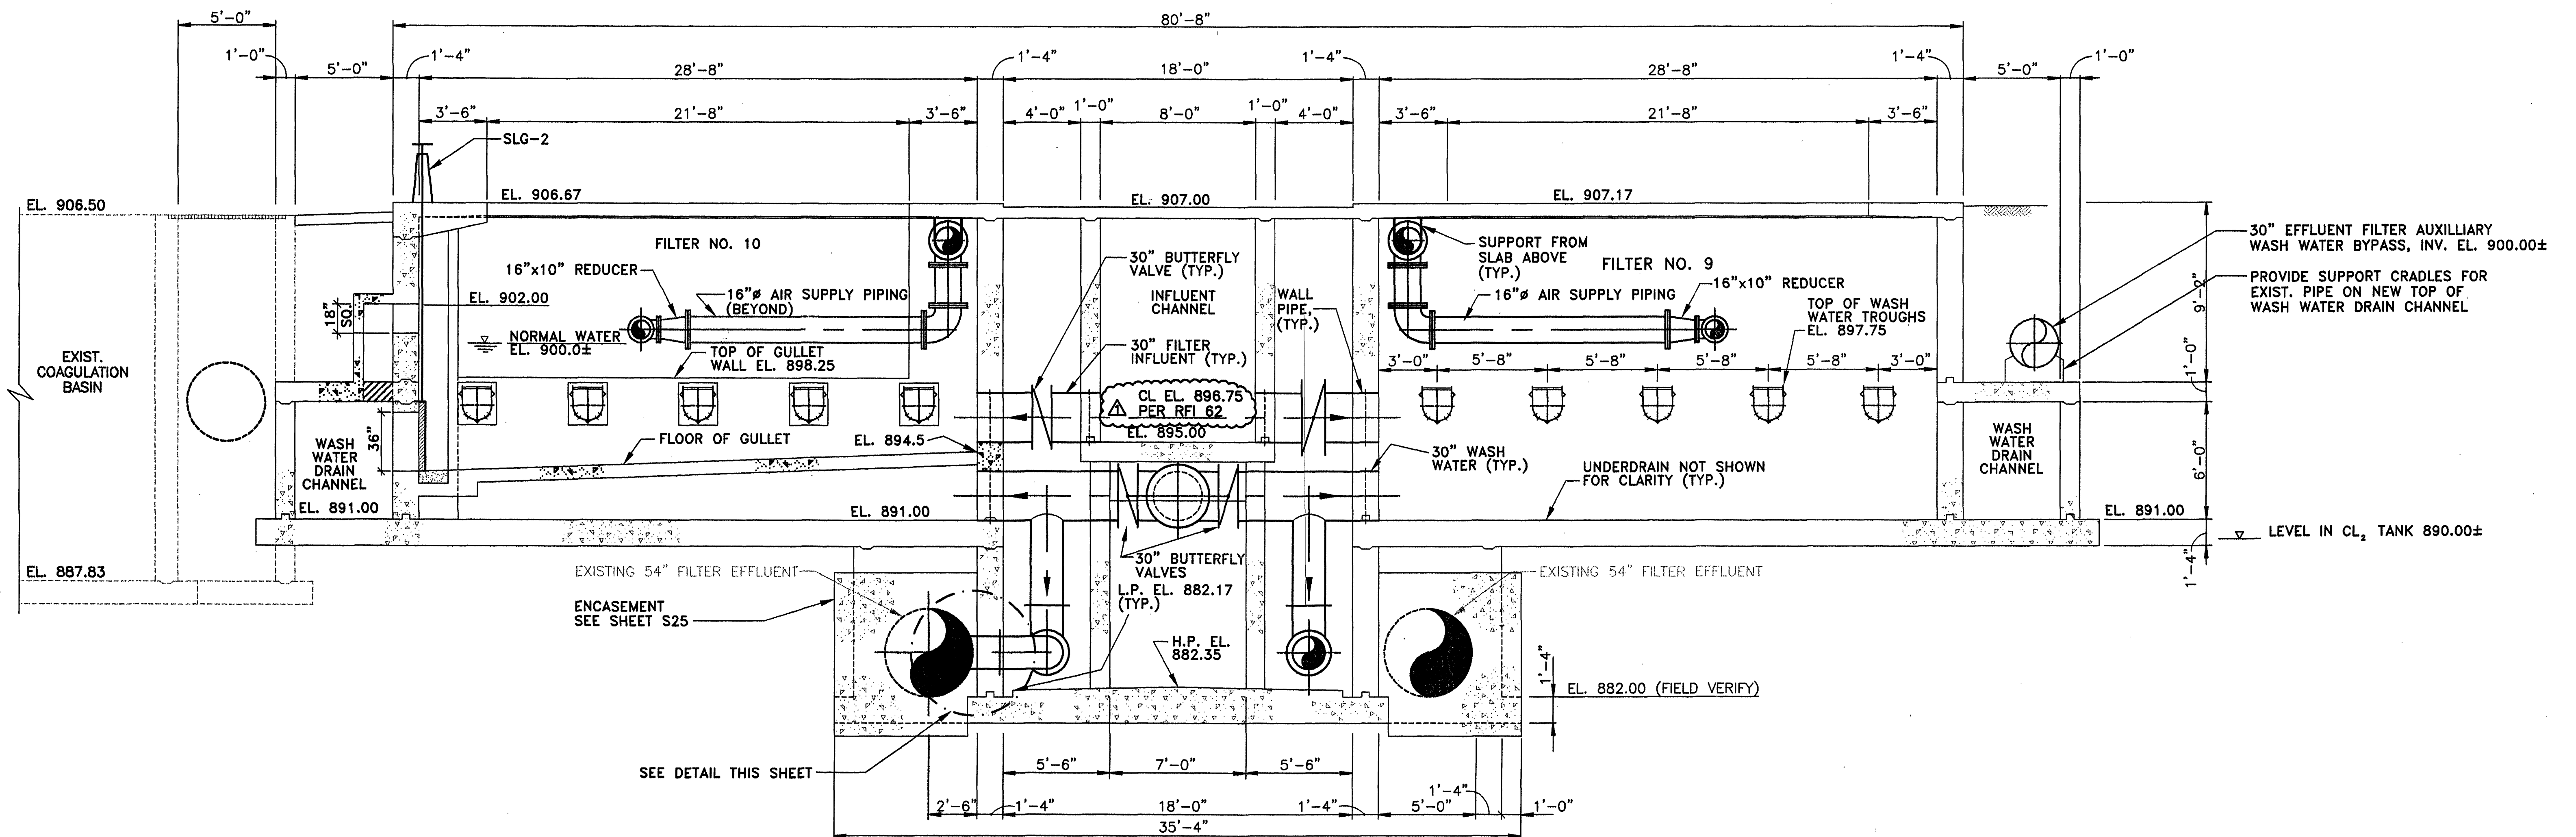

SECTION 1
SCALE: 1/4" = 1'-0"