



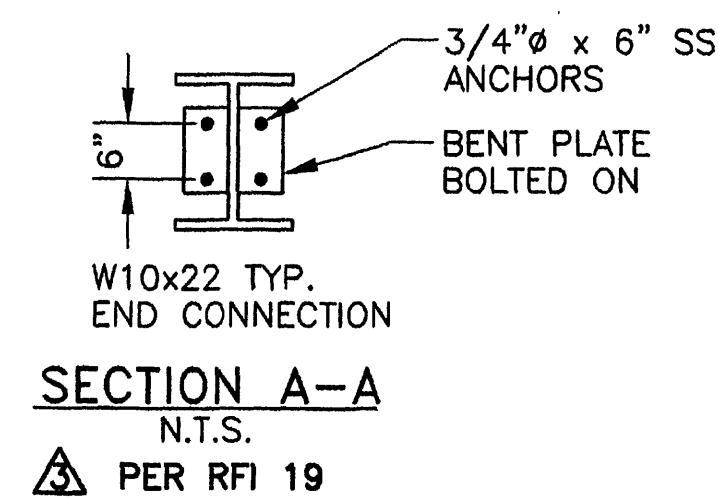

Q OF BEAMS USED AS EXTRA GRATING SUPPORT, W10x22 (TYP. 3) PER RFI 19

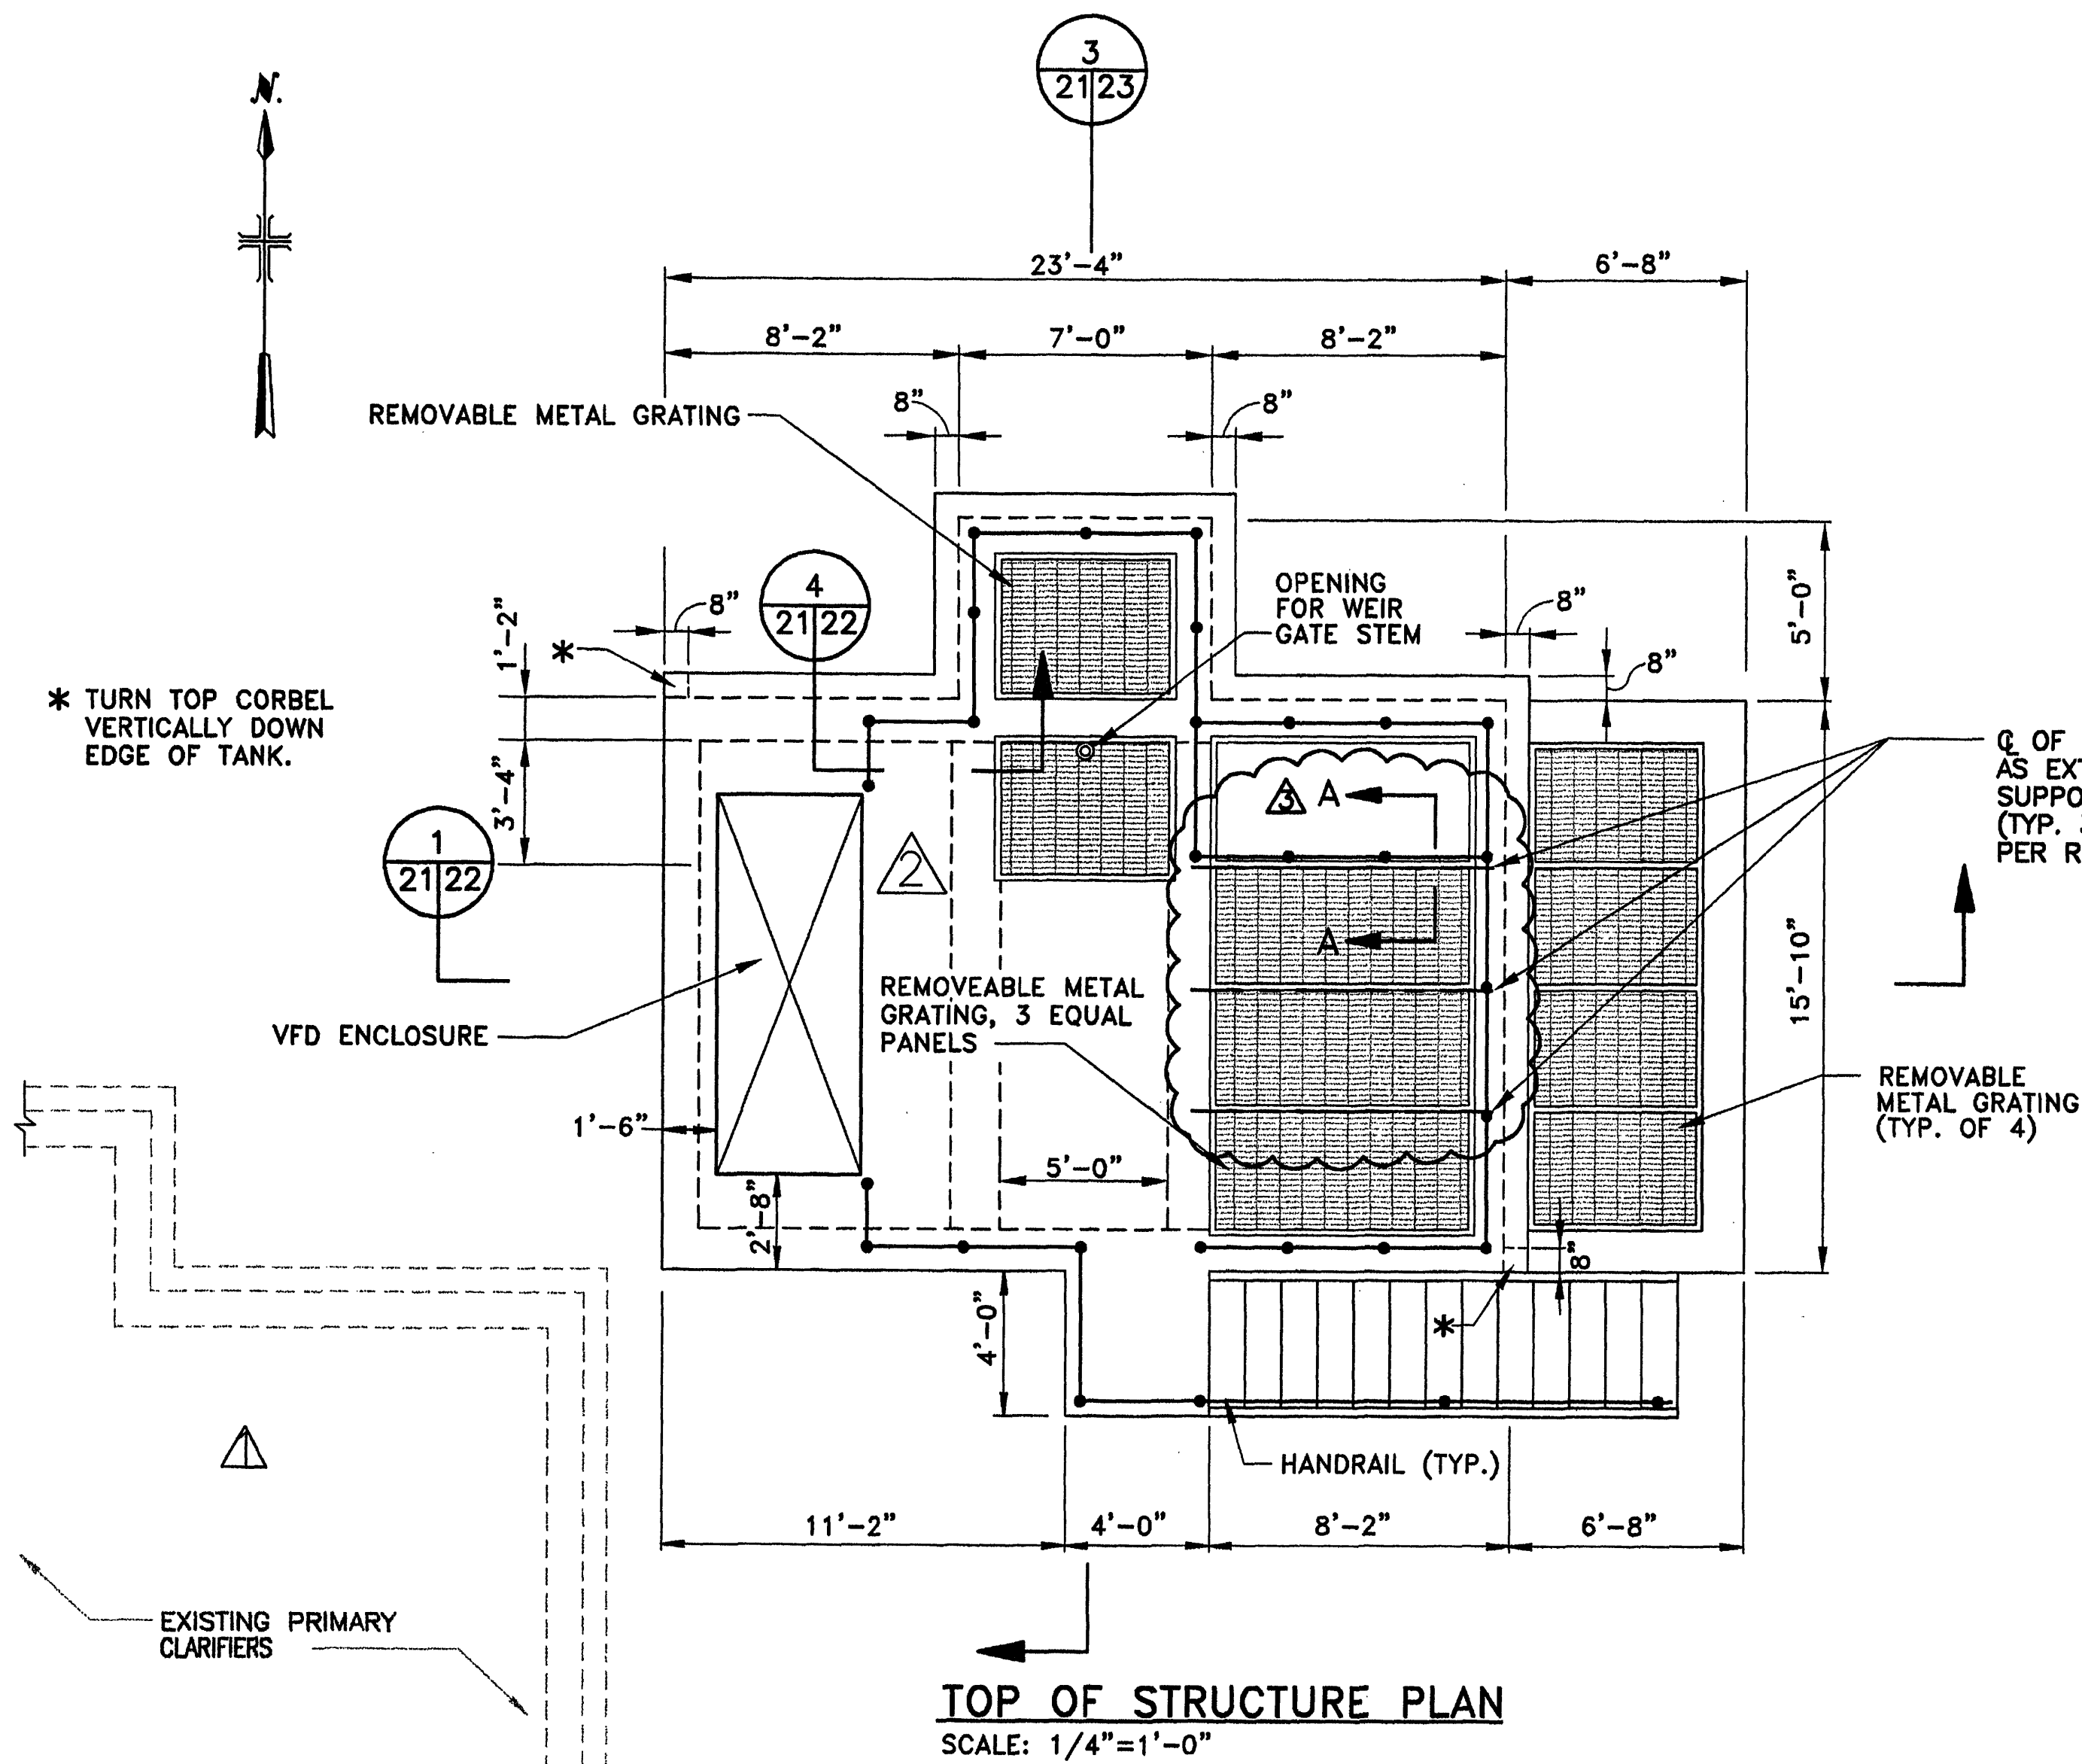