

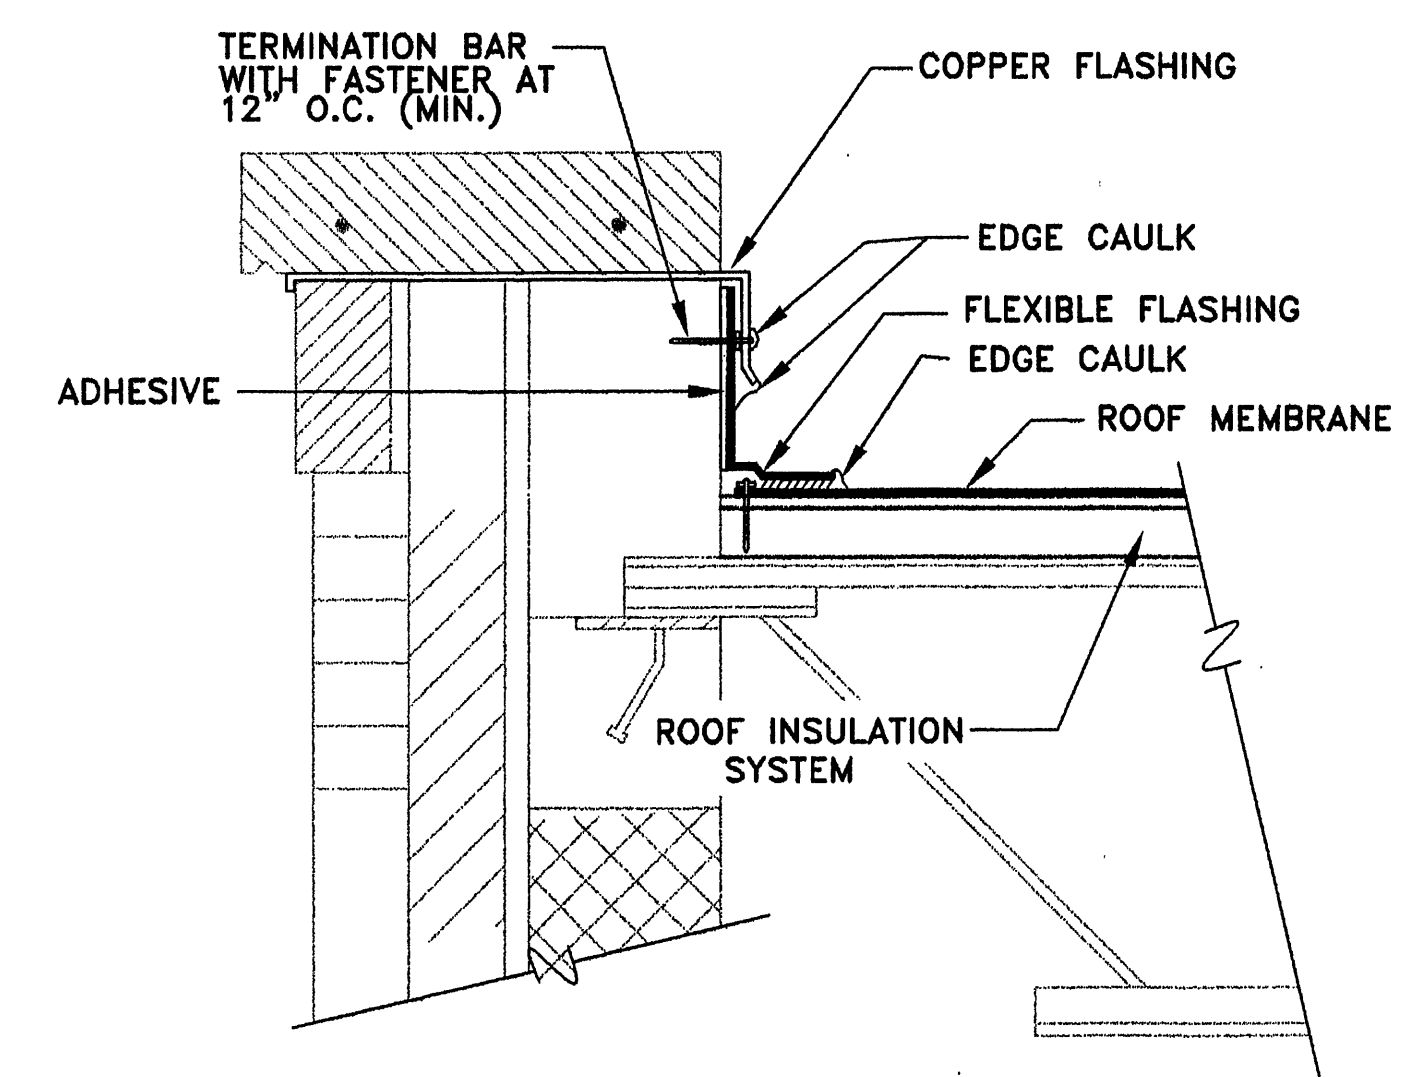
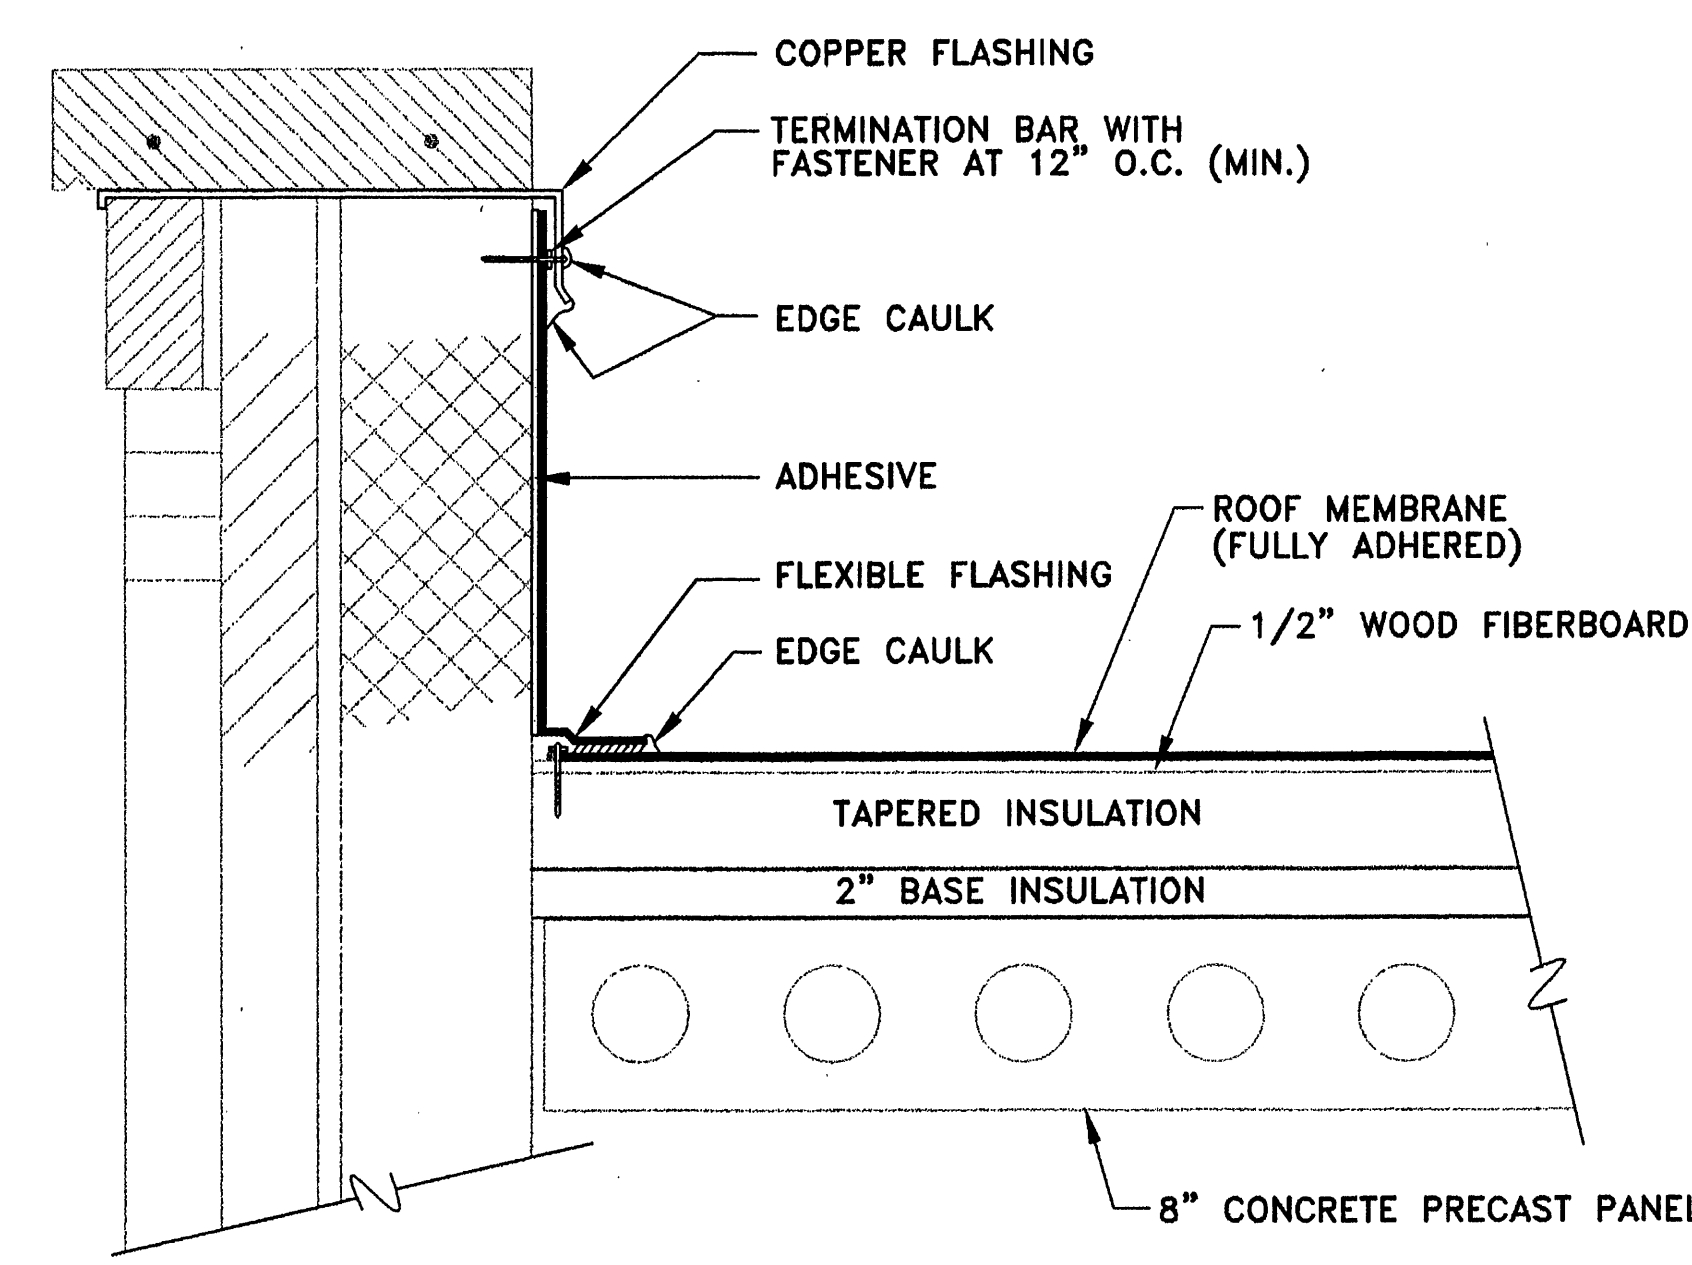
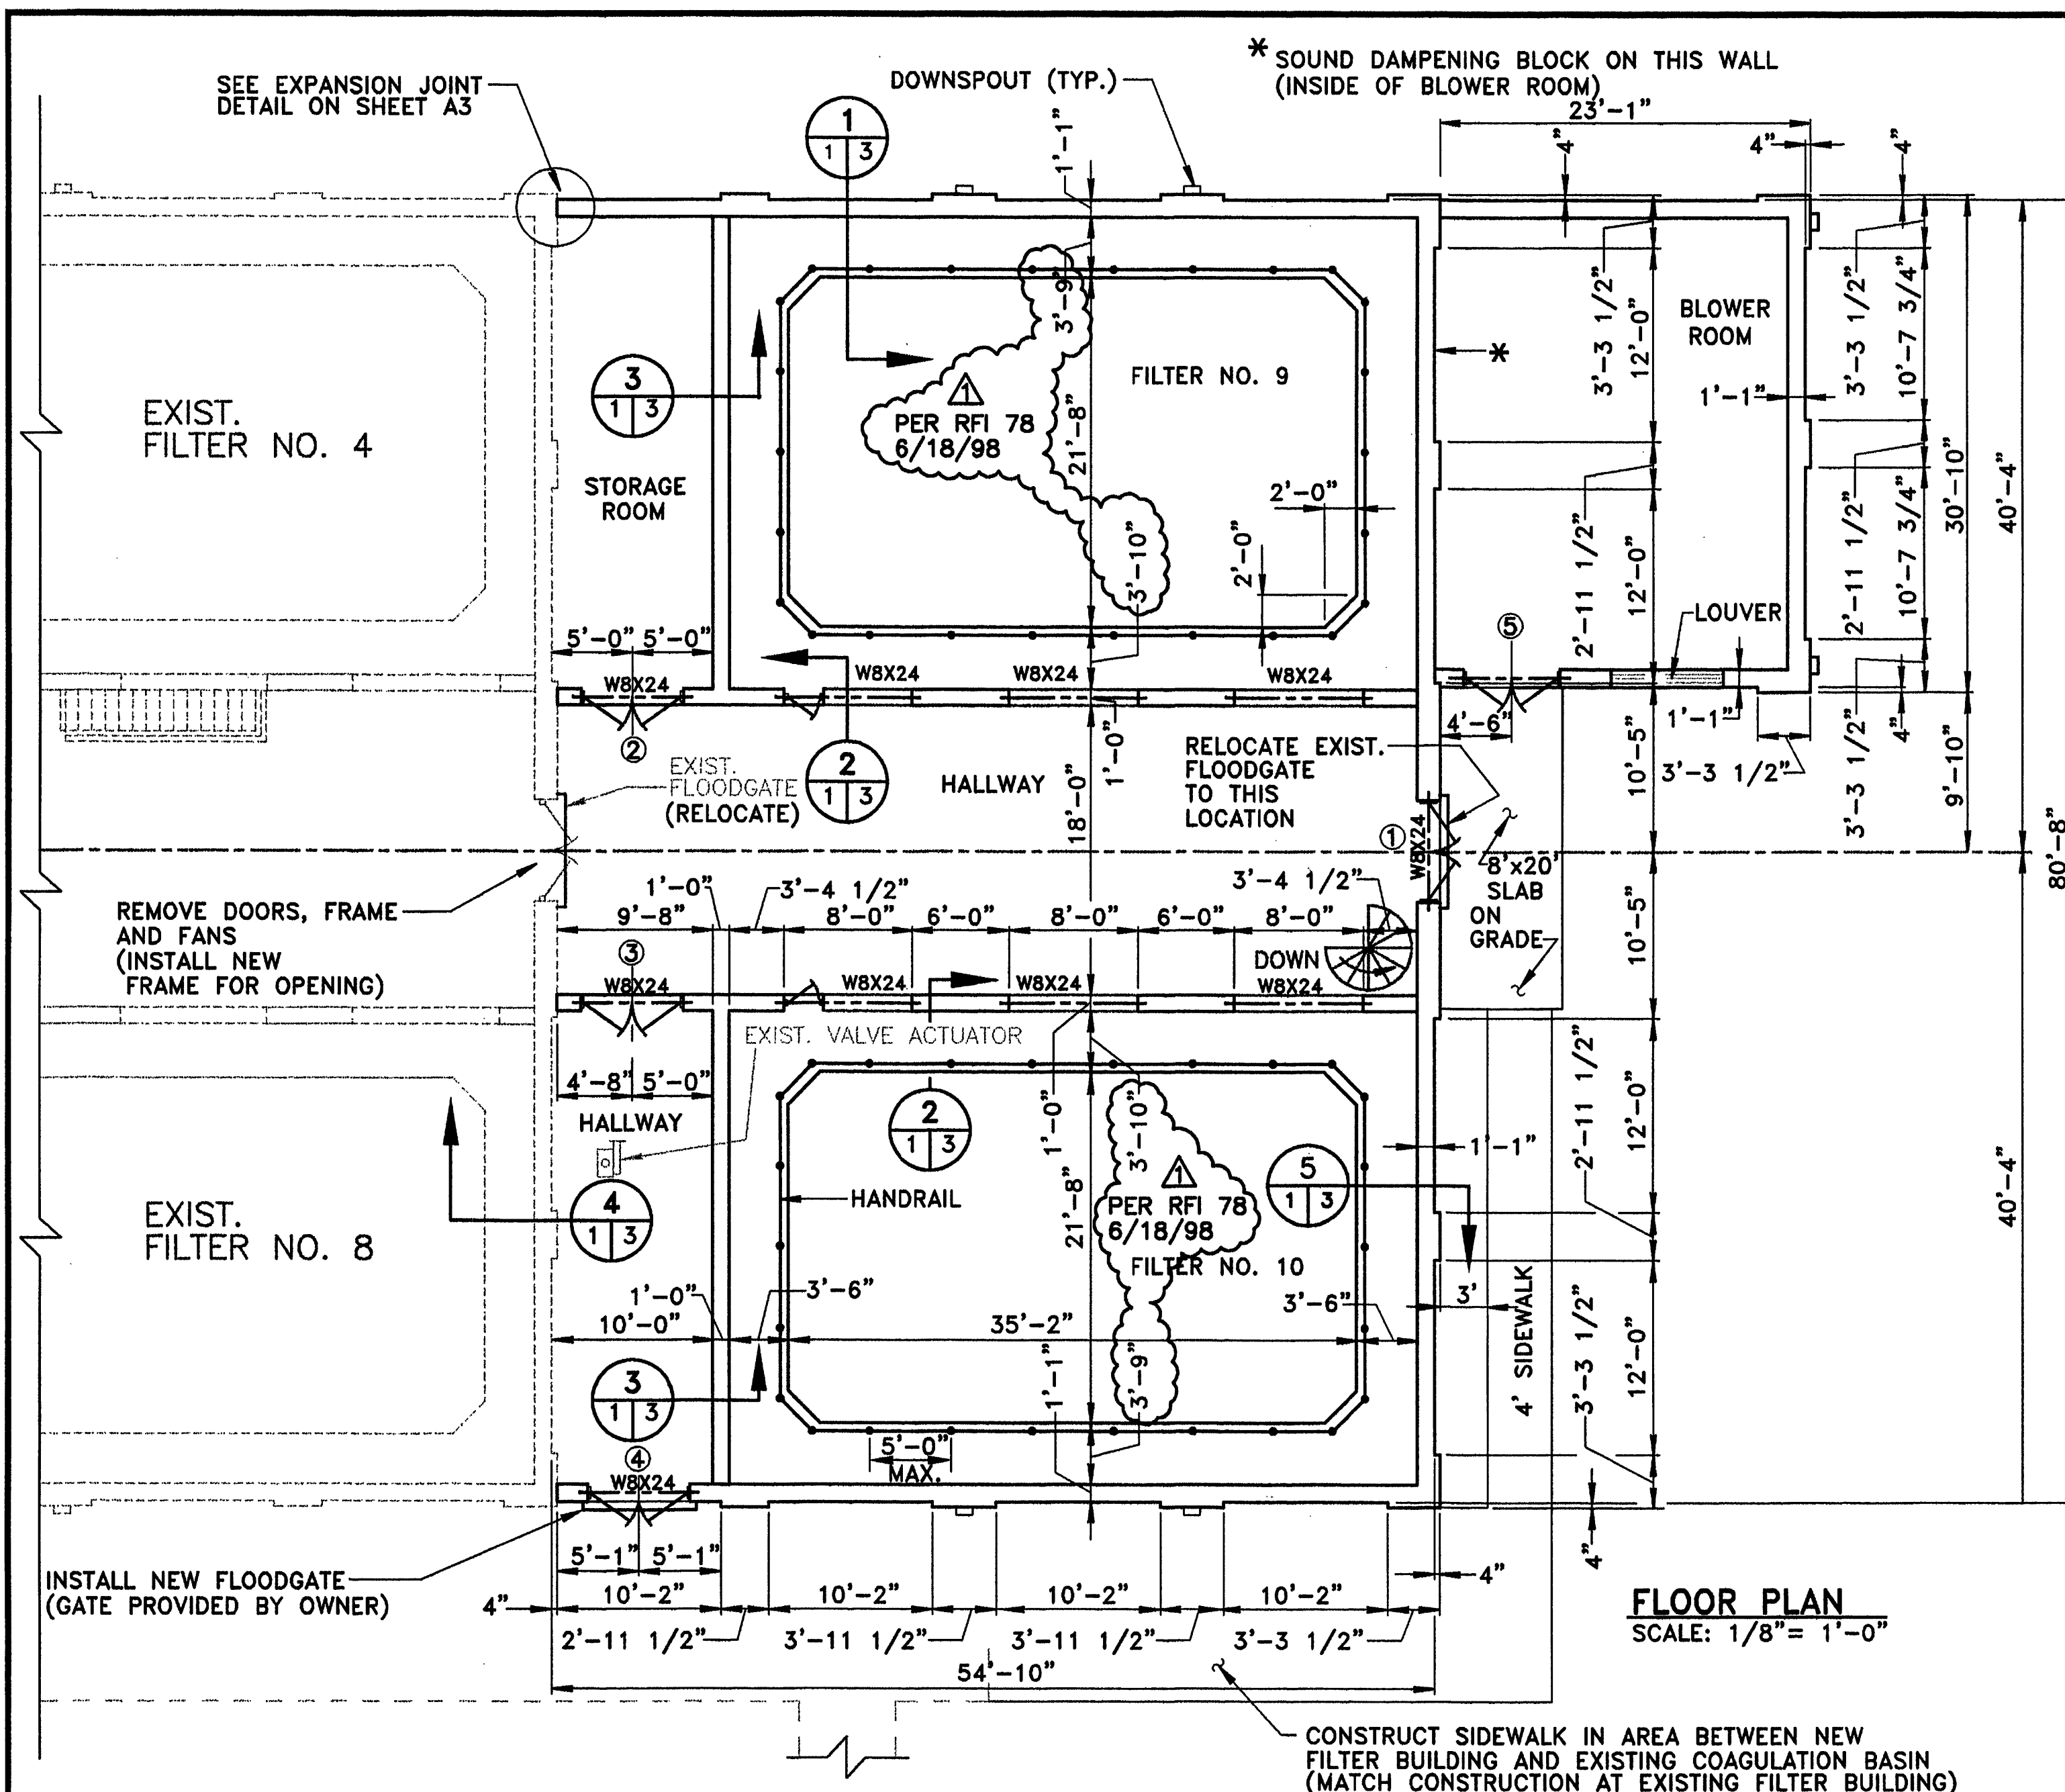




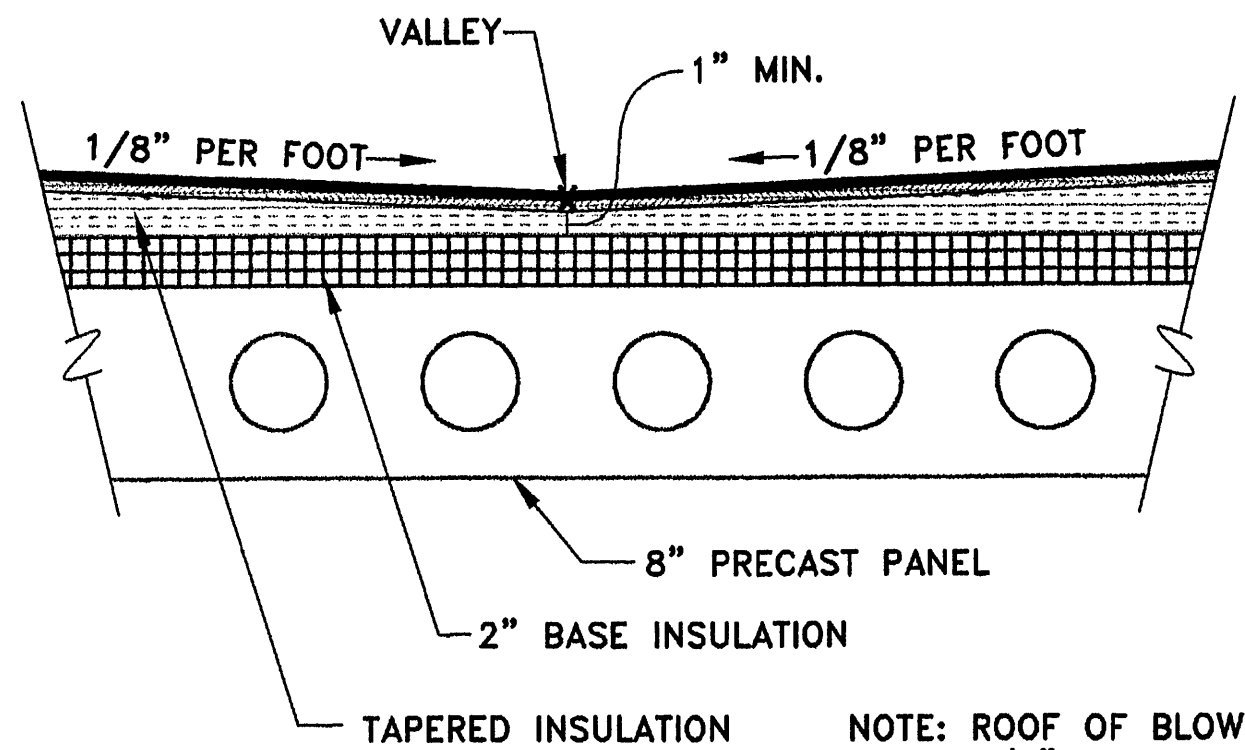


DESIGN LOADS FOR PRECAST ROOF PANELS:

GROUND SNOW LOAD	30 P.S.F.
MINIMUM LIVE LOAD	20 P.S.F.
WIND SPEED	110 MPH
WIND EXPOSURE	C
IMPORTANCE FACTOR	1.15
INCLUDE DEAD LOAD OF PANELS AND ROOF/INSULATION	

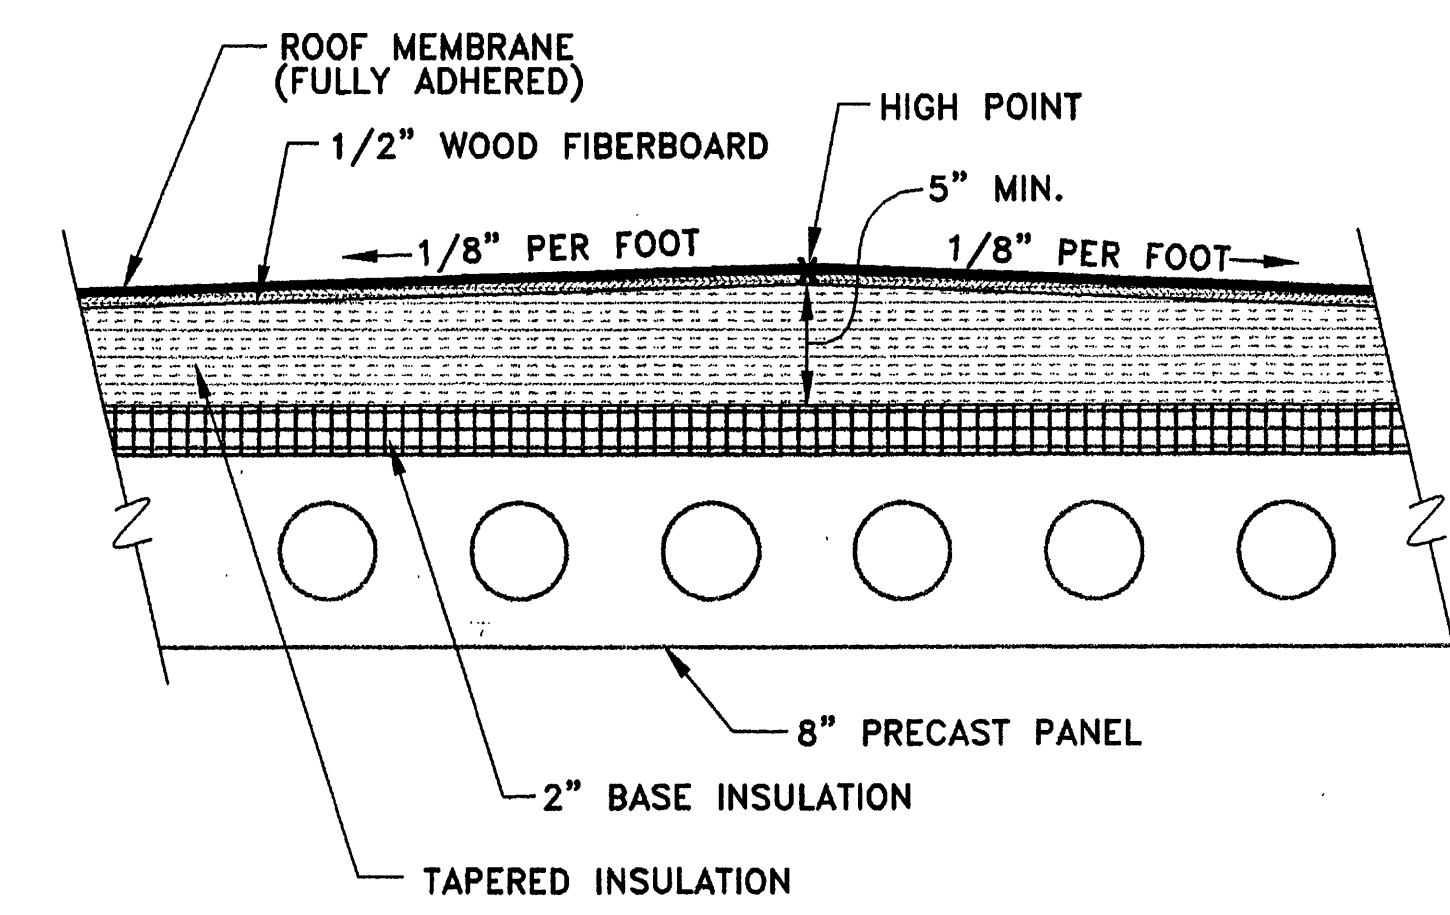

NOTE: ROOF OF BLOWER ROOM TO HAVE 1/2" PERLITE OR SIMILAR PROTECTION BOARD BETWEEN STEEL DECK AND BASE INSULATION (IN ADDITION TO ABOVE ITEMS)

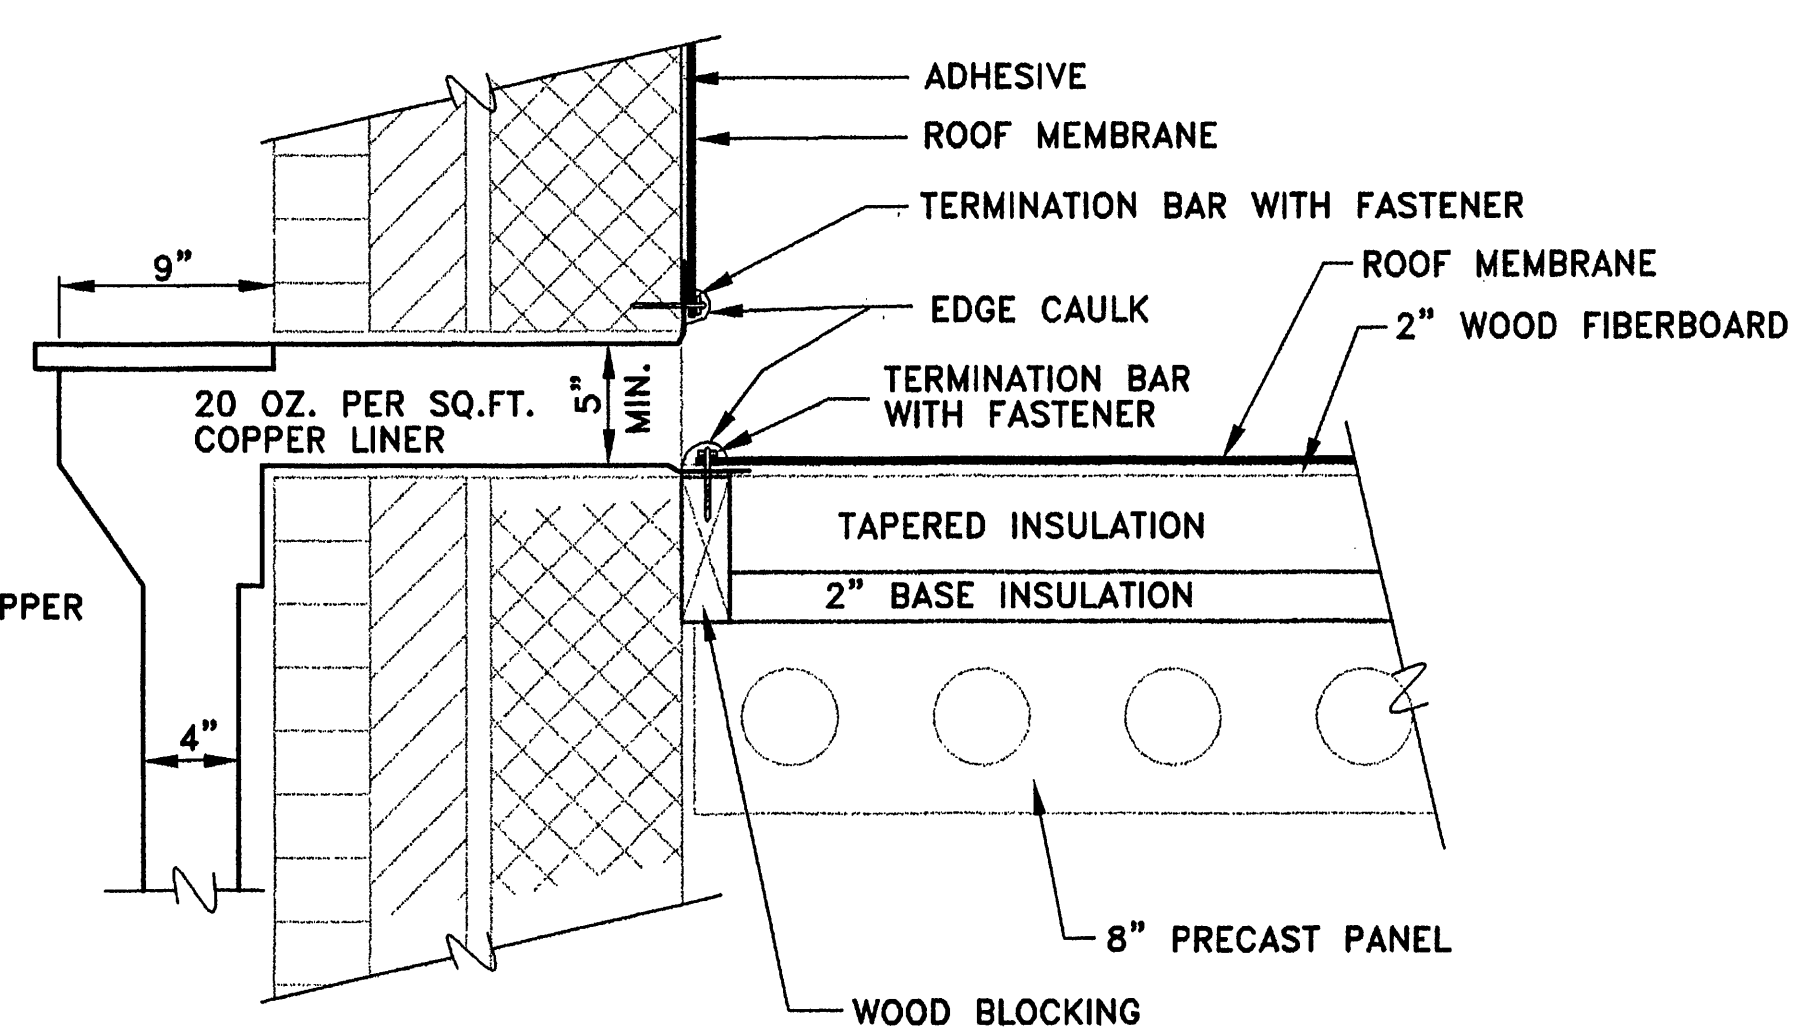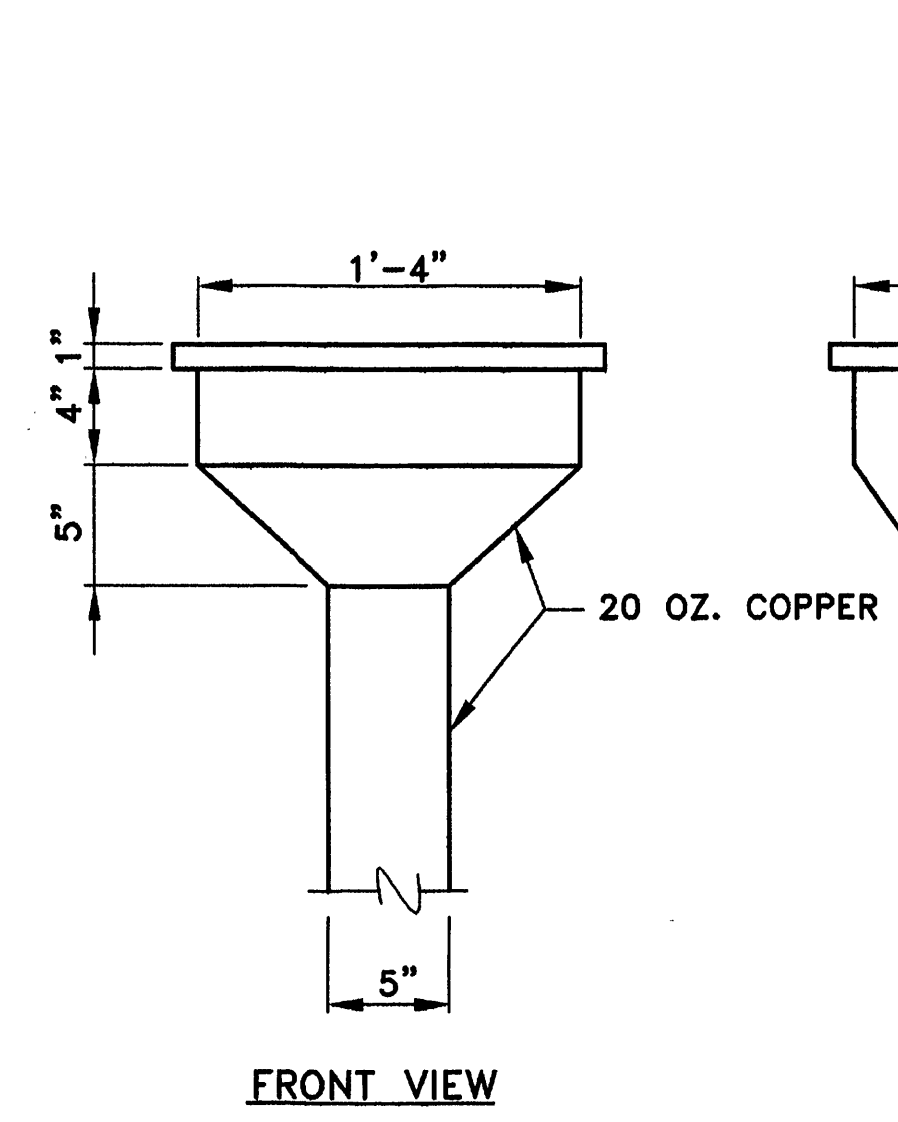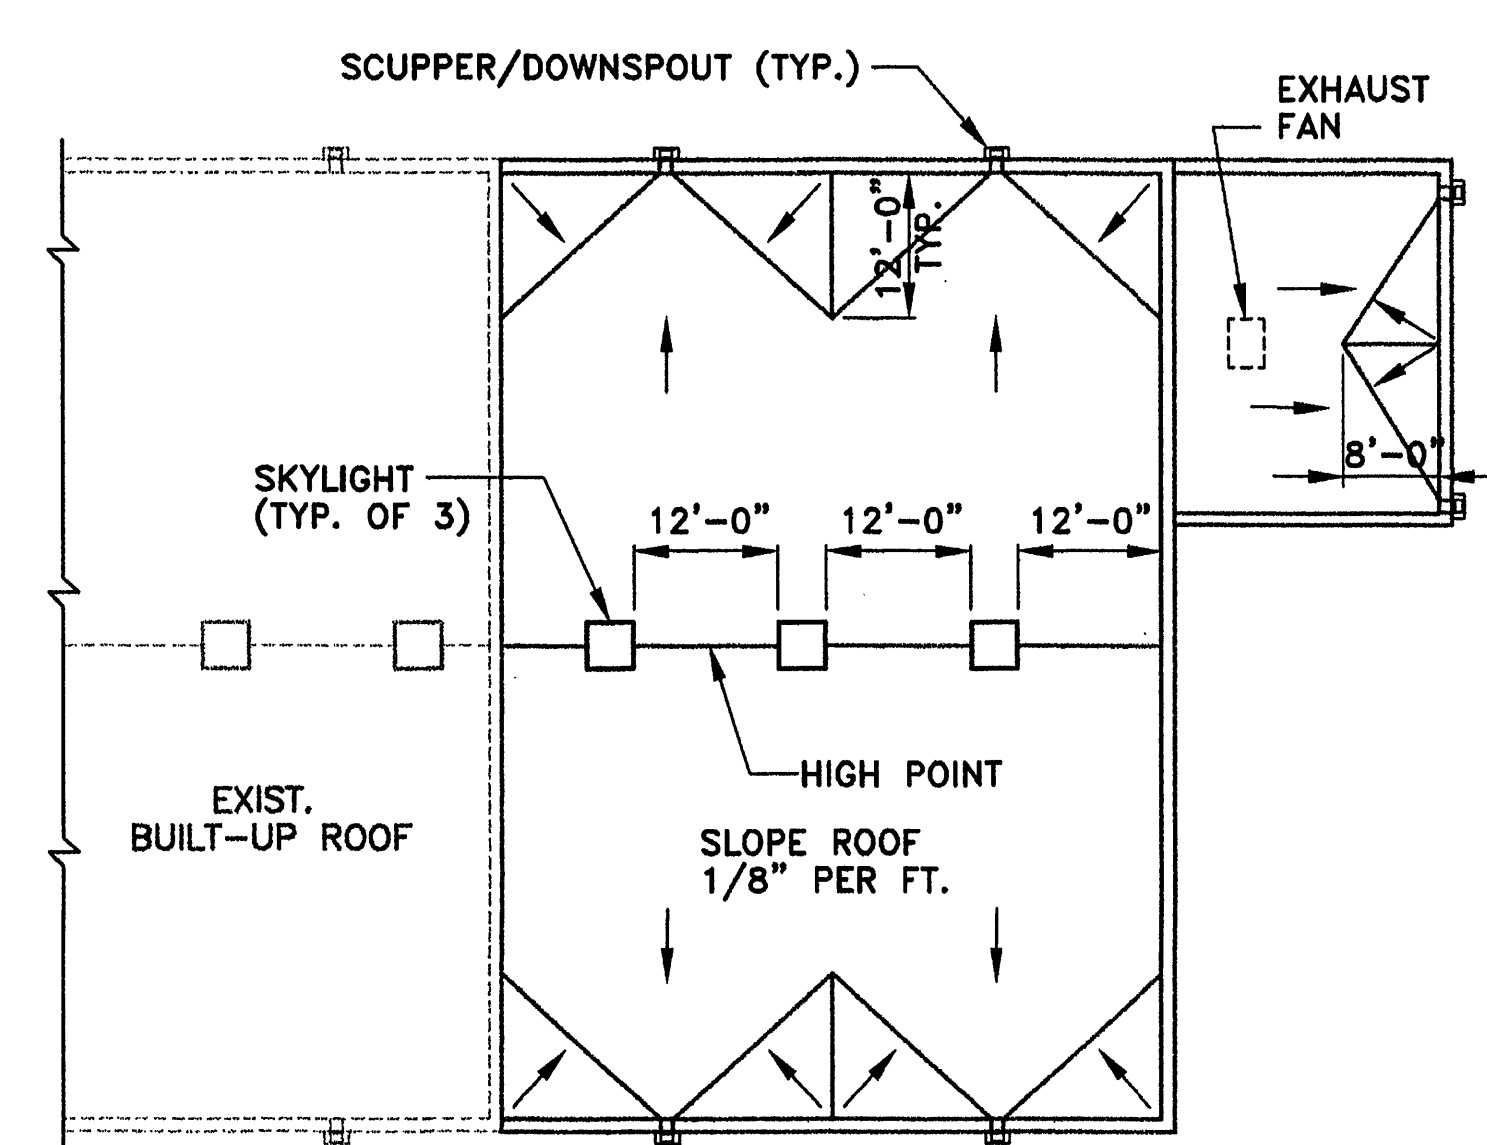

SCUPPER AND DOWNSPOUT DETAILS
SCALE: 1 1/2" = 1'-0"

