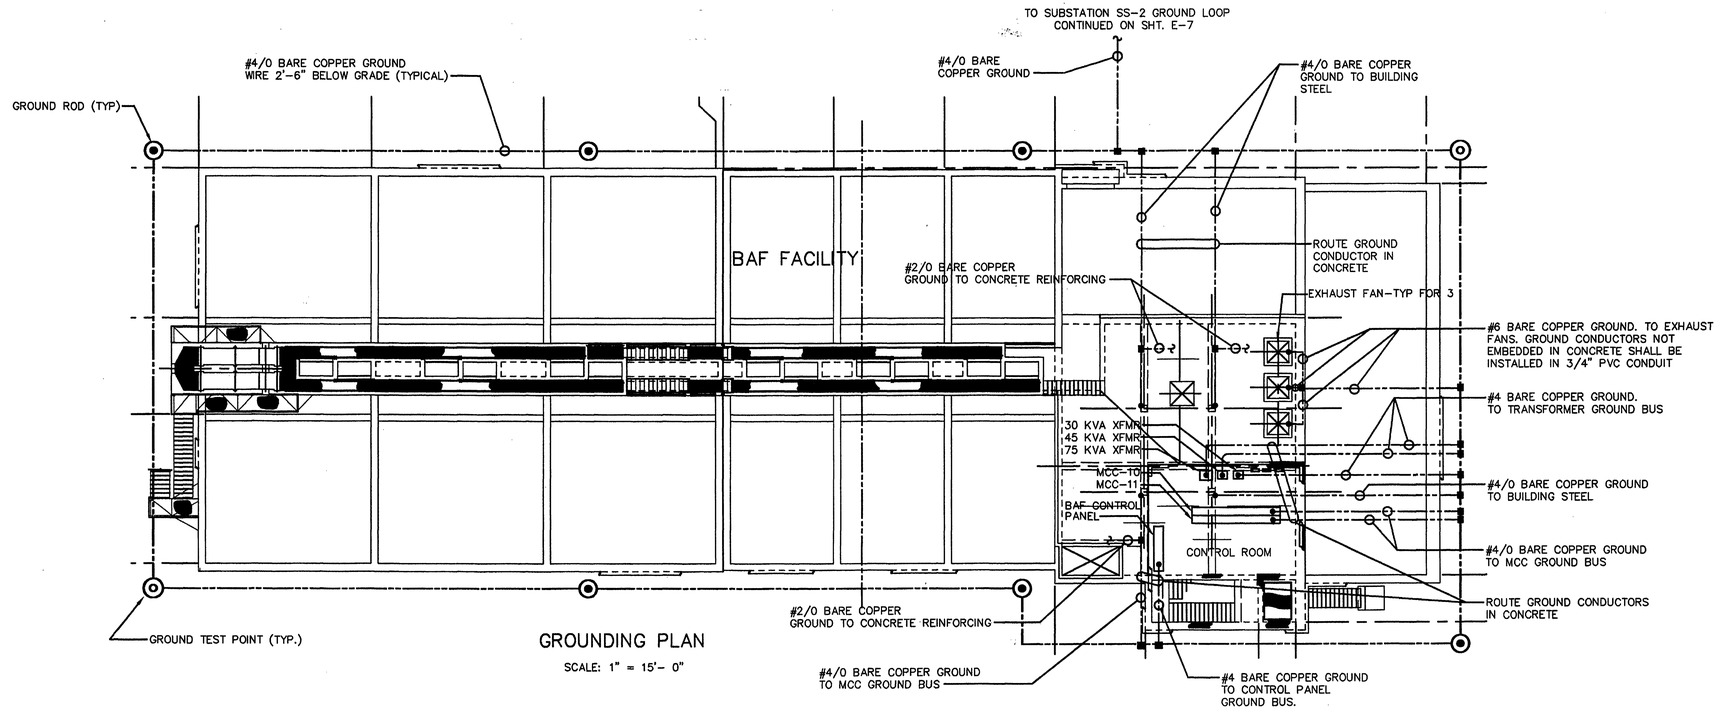

GROUNDING PLAN

SCALE: 1" = 15'- 0"

NOTES:

1. SEE SHEET E-15 FOR AREA CLASSIFICATION
2. FOR LIGHTING FIXTURE SCHEDULE SEE SH. E-12

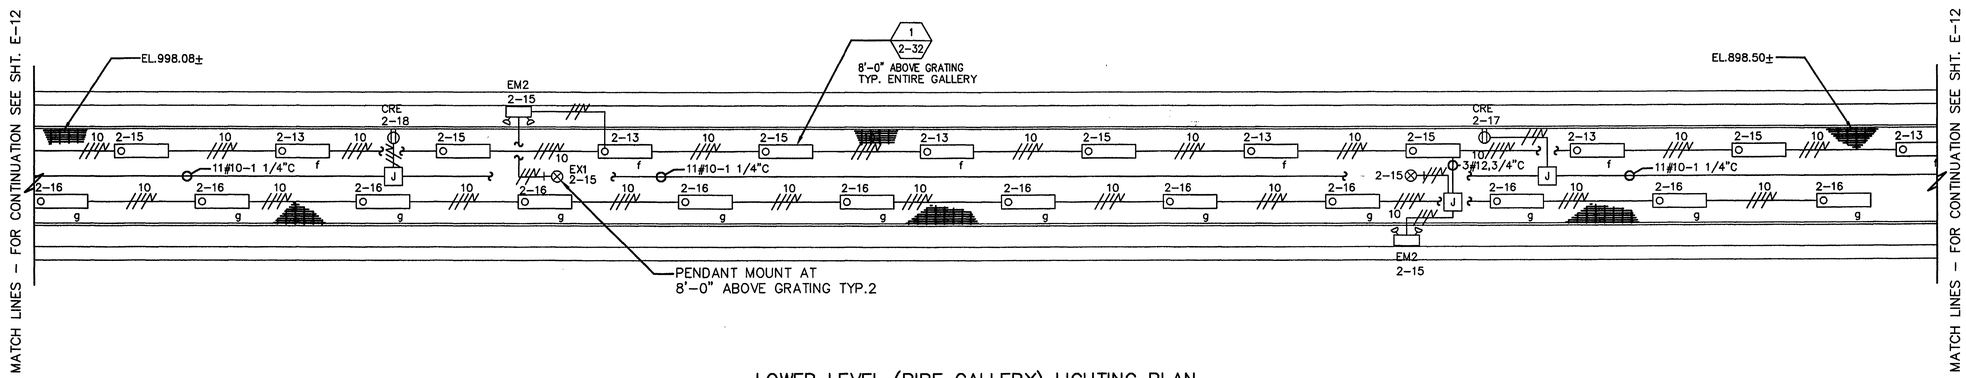

LOWER LEVEL (PIPE GALLERY) LIGHTING PLAN

SCALE: 3/16"=1'-0"

REVISIONS			
NO.	BY	DATE	REMARKS
1	ARB	JAN. 2000	RECORD DRAWING

DES KLL
DWN KLL
CKD TK

MALCOLM PIRNIE
11832 Rock Landing Drive, Suite 400
Newport News, Virginia 23606

ROANOKE VIRGINIA, CHARTERED 1882

CITY OF ROANOKE, VIRGINIA
WATER POLLUTION
CONTROL PLANT
UPGRADE AND EXPANSION

BIOLOGICAL AERATED FILTER
GROUNDING PLAN

SCALE: AS NOTED

COPYRIGHT © 1997
MALCOLM PIRNIE, INC.

DATE MAY 1997

E SHEET 13 OF 36

CAD REF. NO. 0060E688

2037_0060029560E-1.X(CAD)PRO\0060029E\0060E688 Scale: 1:1 Date: 05/05/1997 Time: 08:17